

Name Ralph J. Frissore

Service No. 23

Address 28 ELDRED STREET

Location Lot 117A

Kind of Pipe

Size

Size of Main

~~Repair~~ ~~Renew~~ ~~DK~~ ~~DK~~ New Service

Location *Comp. 6-22-59*

Date	Material	Amount	Total	Date		Amount
	27' 6" V.C. @ 3.00	81.00	81.00	<i>4-10-59</i>	<i>Deposit</i>	<i>200.00</i>
	Installed by Contractor			<i>6-22-59</i>	<i>Paid by W.H. # 42</i>	<i>7.38</i>
						<i>217.38</i>
	Bill to owner when connected					
5-8-59	Labor	61.53				
	10% O.H.	6.15	67.68			
	38' 6" Transite pipe @.70		26.60			
	1 1 1/4" Transite Bend		5.10			
	3 hrs. Town Shovel @6.50		19.50			
	2 hrs. Trucking @.75		1.50			
	1 hr. Rodgers Trailer @3.00		3.00			
	1 hr. Trucking @ 3.00		3.00			
	Labor		207.38			

TOWN OF LEXINGTON—DEPT. OF PUBLIC WORKS
SEWER DIVISION

DATE.....

NO.....


The undersigned applies for the construction of a particular sewer connecting No.....
Street and hereby agrees to comply with the Rules and Regulations governing the construction and use of Particular
Sewers, as now or at any future time established by the Board of Selectmen.

Am't of estimate \$.....

Am't Paid \$.....

..... Owner

Sketch of Service Here

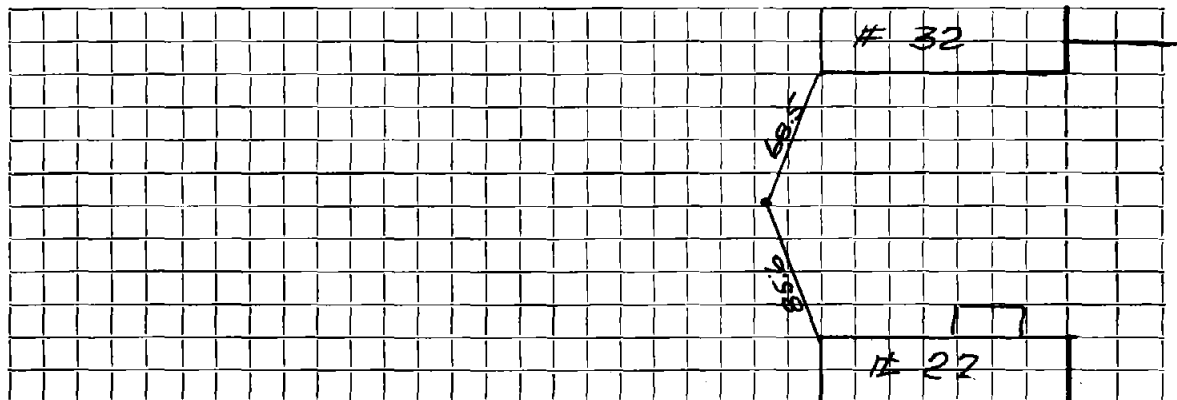

S.S. For # 28

Connection made in..... Street.

Work completed.....19..

Remarks: