

Name William H. Sullivan

Service No. 228

Address 29 Eldred Street

Location

Kind of Pipe

Size

Size of Main

~~Repair/ Renewal~~ - New Service

Comm. 2-20-56

Location

Date	Material	Amount	Total	Date	Amount
12-12-55	Labor	79 76		12-2-55 Deposited	\$ 150 00
	10% overhead	7 98	87 74	2-25-56 Refund	96
	64' - 6" sewer pipe @ .49		31 36		149 04
	1 - 6" elbow		1 35		
	Joint compound		3 84		
	4 hrs. Town shovel @ 6.00		24 00		
	1 hr. trucking		75		
			149 04		
	Labor			* \$96 Refund applied to bal. due on S. H. C. 227	

**TOWN OF LEXINGTON—DEPT. OF PUBLIC WORKS  
SEWER DIVISION**

DATE.....

NO. ....

The undersigned applies for the construction of a particular sewer connecting No.....  
Street and hereby agrees to comply with the Rules and Regulations governing the construction and use of Particular  
Sewers, as now or at any future time established by the Board of Selectmen.


Am't of estimate \$.....

Am't Paid \$.....

..... Owner

---

**Sketch of Service Here**

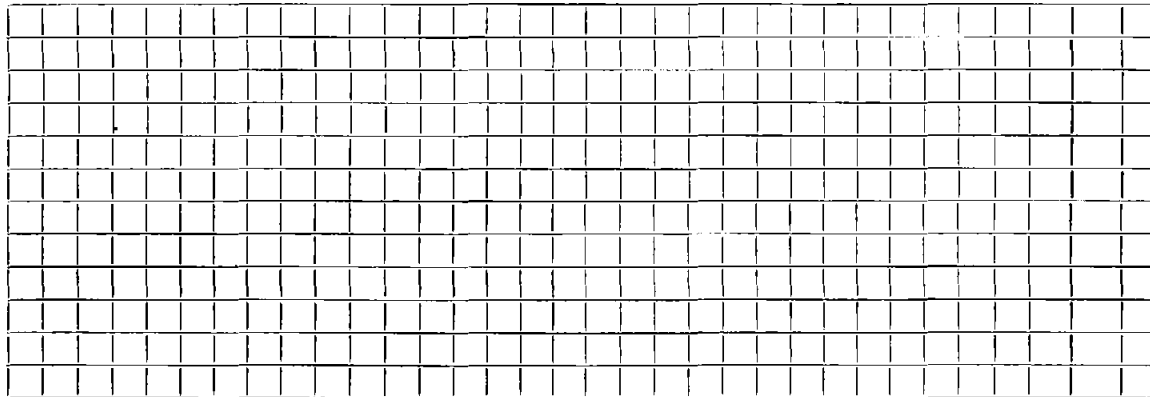

Connection made in..... Street.

Work completed..... 19..

Remarks: