

Name William H. Sullivan

Service No. 170

Address 37 Eldred St., Lexington

Main: 14 Milk St., Lexington

Location

Kind of Pipe

Size

Size of Main

Repair - Renewal - New Service

Location Com. 11-21-55

| Date | Material | Amount | Total | Date | Amount |
|--------|--------------------------|--------|--------|----------|--|
| 9/7/55 | Labor | 84 28 | | 8-17-55 | Deposited 150 00 |
| | 10% Overhead | 8 43 | 92 71 | 11-21-55 | * Refunded (11 86) |
| | 60'-6" Sewer Pipe @.32 | | 19 20 | | 138 14 |
| | 1-6" Elbow | | 1 88 | | |
| | 4 hrs. Town Shovel @5.00 | | 20 00 | | |
| | Joint Compound | | 3 60 | | |
| | 1 hr. trucking @.75 | | 75 | | |
| | | | 138 14 | | * \$188 made payable to Town to apply on SAC #171 |
| | Labor | | | | |

TOWN OF LEXINGTON—DEPT. OF PUBLIC WORKS

SEWER DIVISION

DATE

NO.


The undersigned applies for the construction of a particular sewer connecting No. Street and hereby agrees to comply with the Rules and Regulations governing the construction and use of Particular Sewers, as now or at any future time established by the Board of Selectmen.

Am't of estimate \$.

Am't Paid \$.

..... Owner

Sketch of Service Here

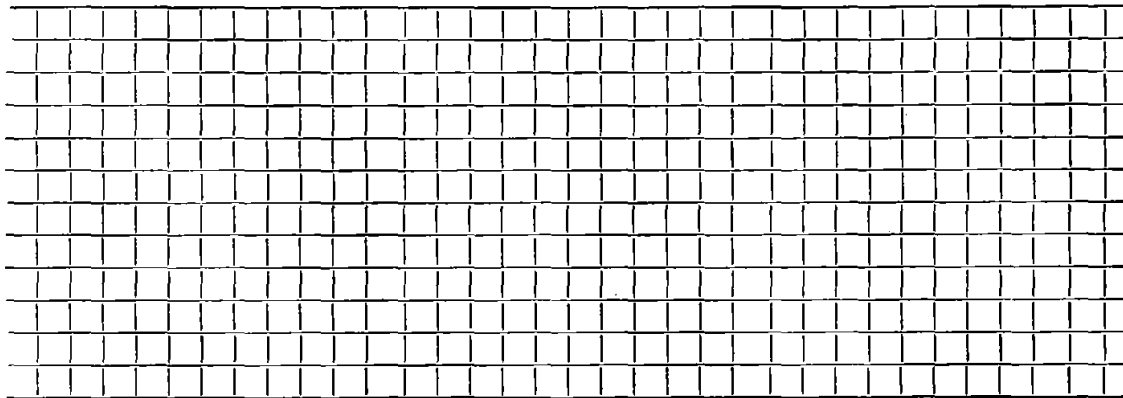

Connection made in Street.

Work completed 19..

Remarks: