

Name William H. Sullivan

Service No. 219

Address 38 Eldred Street

Location

Kind of Pipe

Size

Size of Main

~~Repair or Renewal~~ — New Service

Comm. 2-20-56

Location

Date	Material	Amount	Total	Date	Amount
12-9-55	Labor	84 28		11-29-55	Deposited 150 00
	10% overhead	8 43	92 71	3-2-56	Paid by refund 1 81
	60' 6" sewer pipe @ .49		29 40		151 81
	1 - 6" elbow		1 35		
	Joint compound		3 60		
	4 hrs. town shovel @ 6.00		24 00		
	1 hr. trucking		75		
			<u>151 81</u>		
	Labor				* Paid from refund on W.H.C. #371

TOWN OF LEXINGTON—DEPT. OF PUBLIC WORKS  
**SEWER DIVISION**

DATE.....

NO. ....


The undersigned applies for the construction of a particular sewer connecting No.....  
Street and hereby agrees to comply with the Rules and Regulations governing the construction and use of Particular  
Sewers, as now or at any future time established by the Board of Selectmen.

Am't of estimate \$.....

Am't Paid \$.....

..... Owner

**Sketch of Service Here**

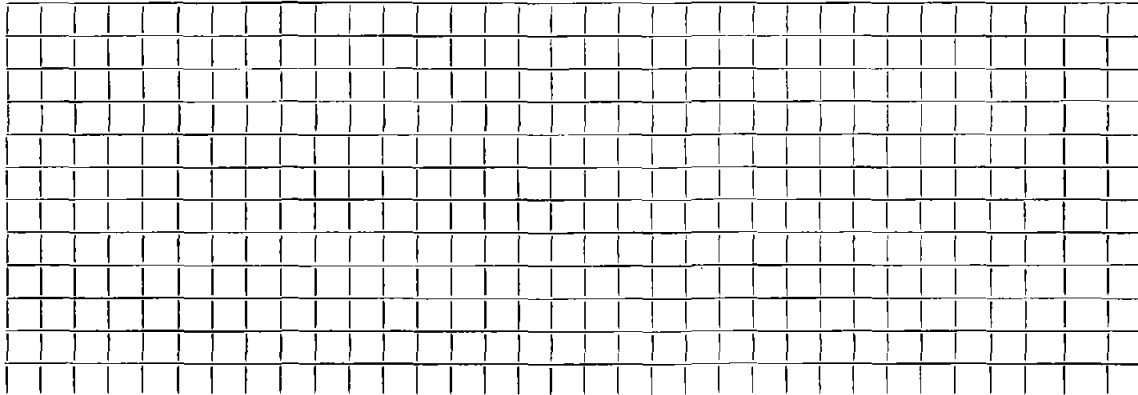

Connection made in..... Street.

Work completed..... 19..

Remarks: