

Name

Service No.

Address 43 Eldred Street

Location Lot 384

Kind of Pipe

Size

Size of Main

Repair—Renewal—New Service

Location


Date	Material	Amount	Total	Date	Amount
2-2-59	20' 6" Transite				
	1 6" - 2 2 1/2" Elbow				
	Bill When Connected		57 94		

DATE \_\_\_\_\_

TOWN OF LEXINGTON — BOARD OF PUBLIC WORKS

SEWER DIVISION

Sketch of Service Here

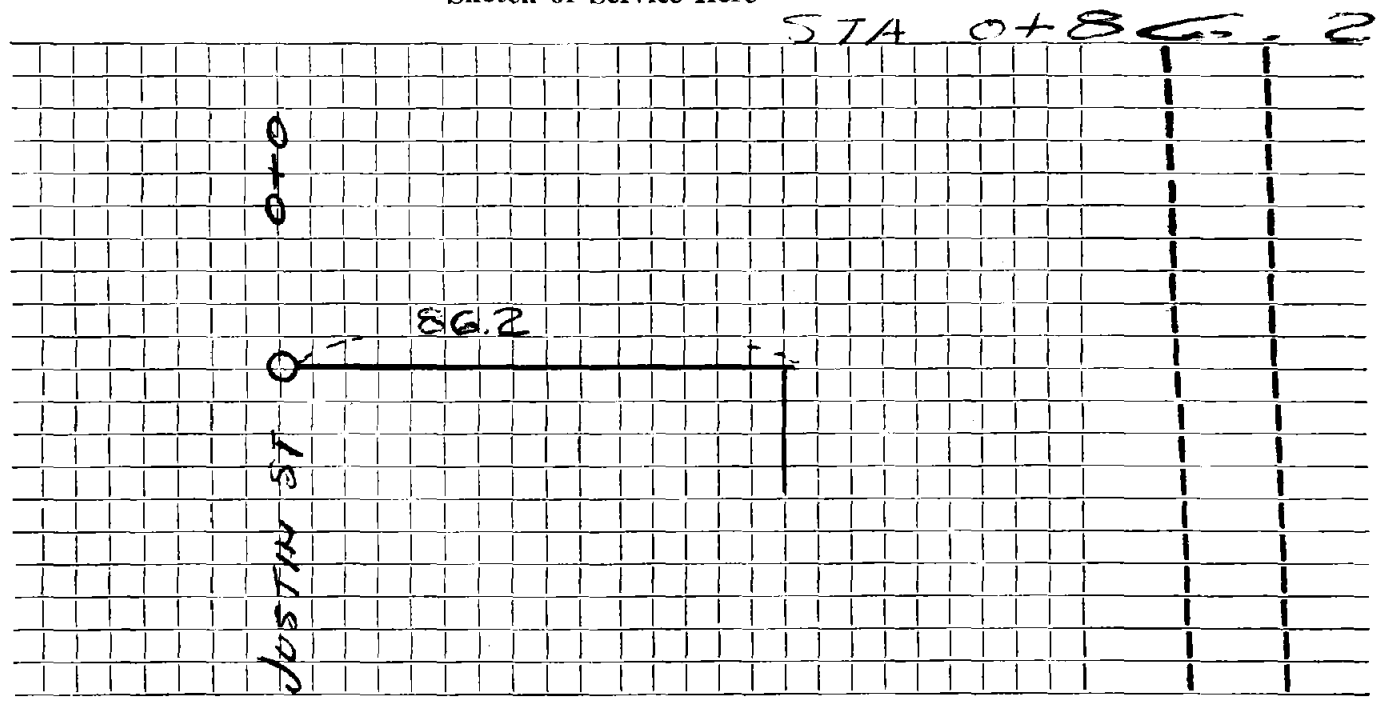

Connection made in ..... Street. Work completed .....

Remarks: .....  
.....  
.....