

Name Harold C. Wilson

Service No. 156

Address 421 Eldred Street

LOT # 392

Location

Kind of Pipe

Size

Size of Main

~~Repair Renewal~~ New Service J.M. Lucente Co. - Permit #94

Location DEC 21 1964


Date	Material	Amount	Total	Date	Amount
0-1-59	Labor	24 50		9-14-64	57 94
	10% O. H.	2 45	26 95		
	20' 6" Transite pipe @.70		14 00		
	1 Elbow		2 24		
	2 Hrs. Shovel @6.50		13 00		
	1 Hr. Trucking		75		
	1 Hr. Pump		1 00		
			57 94		
	BILL WHEN CONNECTED				
2-29-64	42' 6" Transite Pipe				

DATE \_\_\_\_\_

TOWN OF LEXINGTON — BOARD OF PUBLIC WORKS

SEWER DIVISION

44 Sketch of Service Here

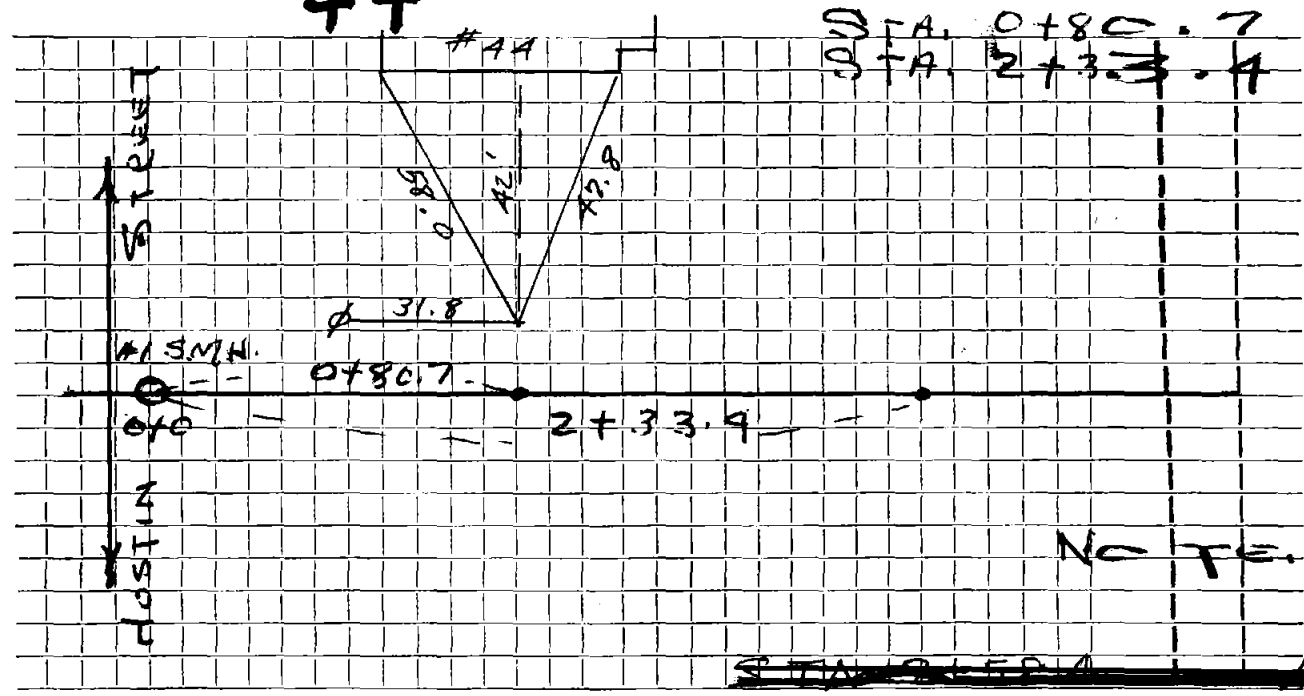

Connection made in ..... Street. Work completed .....

Remarks: .....  
.....  
.....

Name Harold C. Wilson

Service No. 156

Address 141 Eldred Street

LOT # 392

Location

Kind of Pipe

Size

Size of Main

~~Repair Renewal~~ New Service J.M. Lucente Co. - Permit #94

Location DEC 8 1964

Date	Material	Amount	Total	Date	Amount
-1-59	Labor	24 50		9-14-64	57 94
	10% O. H.	2 45	26 95		
	20' 6" Transite pipe @.70		14 00		
	1 Elbow		2 24		
	2 Hrs. Shovel @6.50		13 00		
	1 Hr. Trucking		75		
	1 Hr. Pump		1 00		
			57 94		
	BILL WHEN CONNECTED				
9-64	42' 6" Transite Pipe				


DATE \_\_\_\_\_

TOWN OF LEXINGTON — BOARD OF PUBLIC WORKS

SEWER DIVISION

44

Sketch of Service Here

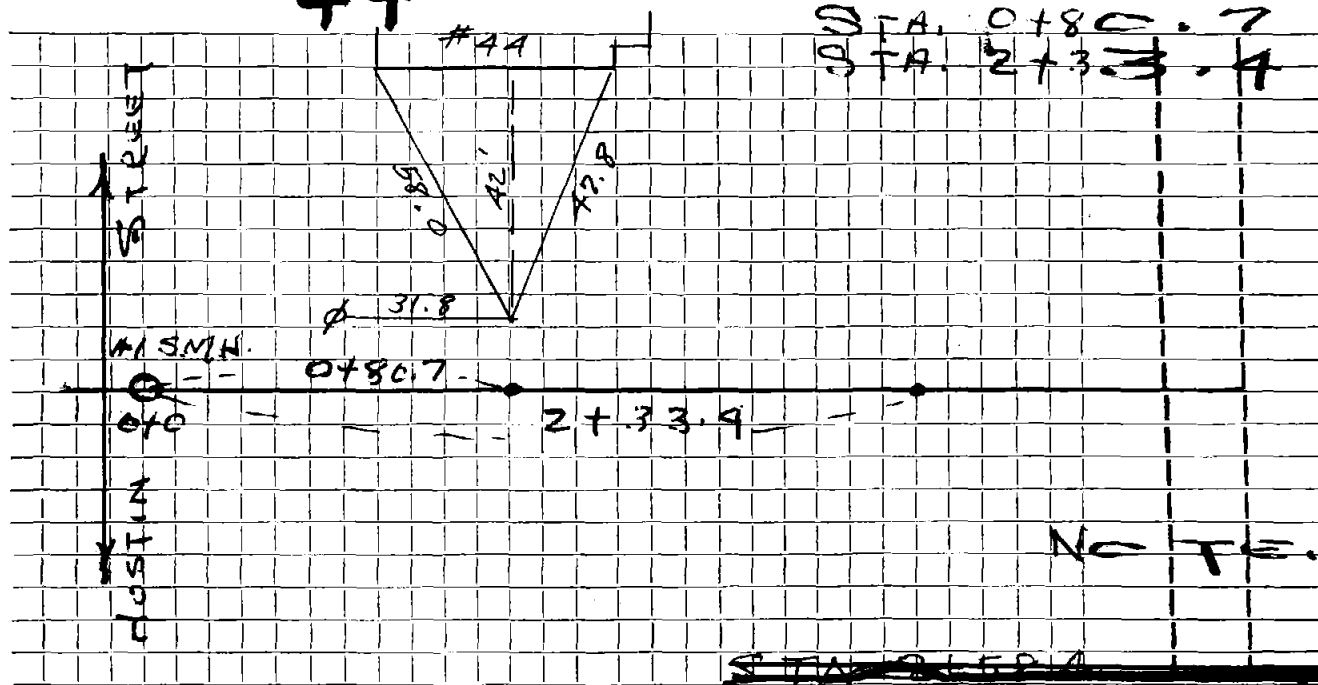

NOTE. 2 SERVICES FORTH B L.

~~STA. 2+33.9~~

Connection made in ..... Street. Work completed .....

Remarks: .....

.....

.....