

Name **Harold C. Wilson**

Service No. 37

Address **45 E Eldred Street**

Lot 385

Location

Kind of Pipe

Size

Size of Main

~~Repair Renewal~~ **New Service**

WO # 8622

Location


Comm 5-18-64

Date	Material	Amount	Total	Date	Amount
2-59	Labor	24 50		4-1-64	200 00
	10% O. H.	2 45	26 95	5-18-64	48 83
20'	6" Transite pipe @.70		14 00		151 17
1	22 1/2° EL bow		2 24		
2	Hrs. SHO vel @6.50		13 00		
1	Hr. Trucking		75		
1	Hr. Pump		1 00		
			57 94		
	BILL WHEN CONNECTED				
-64	Labor	34 51			
	10% O. H.	3 45	37 96		
45'	6" Transite Pipe @.82		36 90		
1	Bag Cement		1 55		
2	3/4 Ton Stone 1 1/2" @1.50		4 12		
2	1 1/2" Transite Elbows @2.35		4 70		
1	Hr. Trucking @3.00		3 00		
5	X 3 Patch		5 00		
			151 17		
					* Apply 5.22 to W/H #17

DATE _____

TOWN OF LEXINGTON — BOARD OF PUBLIC WORKS
SEWER DIVISION

Sketch of Service Here

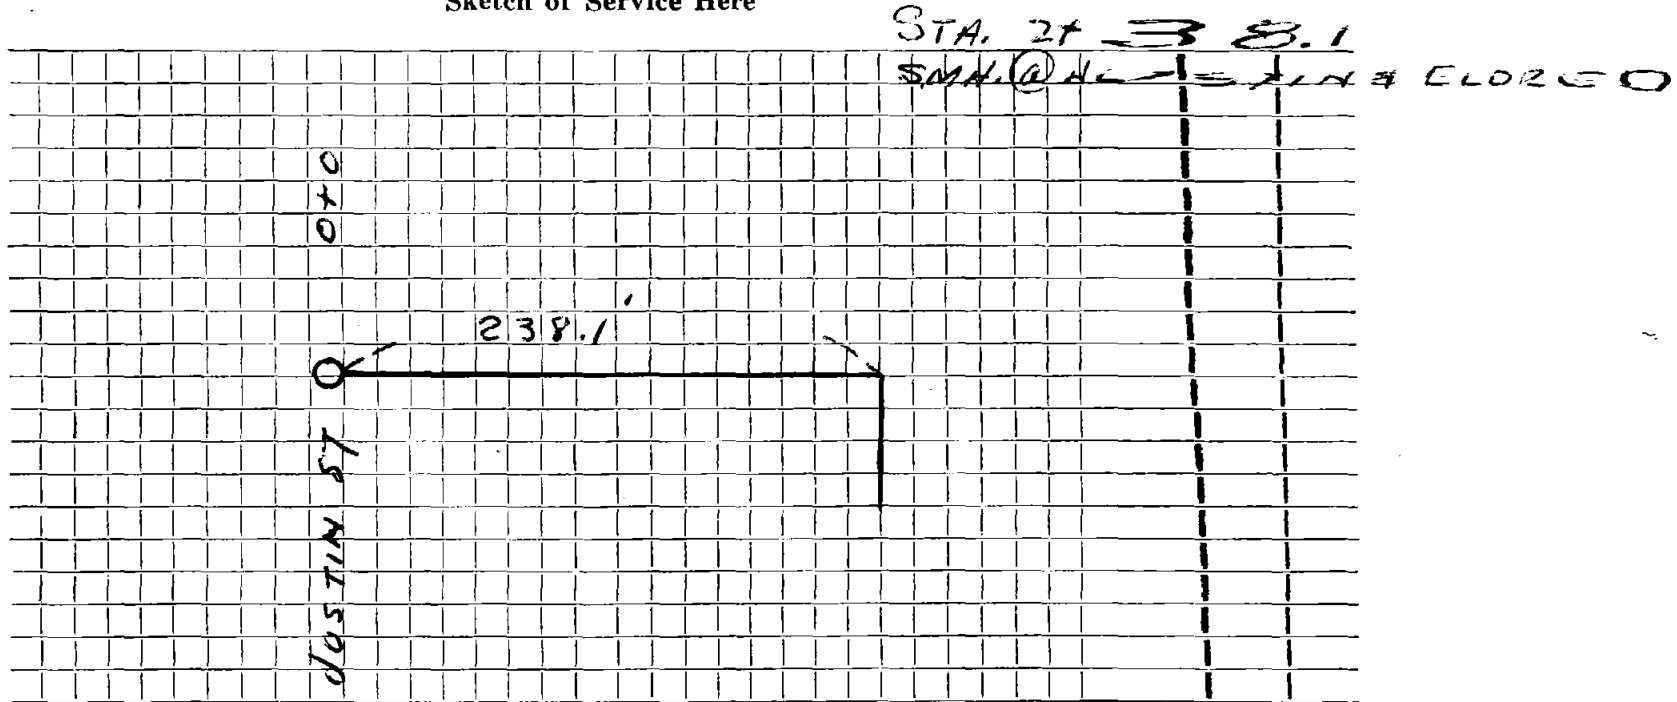

Connection made in Street. Work completed

Remarks:
.....
.....