

Name Harold C. Wilson

Service No. 157

Address 46 Eldred Street

LOT 391

Location

Kind of Pipe

Size

Size of Main

~~Repair~~ ~~Renewal~~ **New Service**

J.M. Lucente co. Permit #95

Location DEC 28 1964

Date	Material	Amount	Total	Date	Amount
-1-59	Labor	24 50		9-14-64	57 94
	10% O. H.	2 45	26 95		
	20' 6" Transite pipe @.70		14 00		
	1 Elbow		2 24	10-1-59	
	2 Hrs. Shovel @6.50		13 00		20' 6" Transite
	1 Hr. Trucking		75		1 6" Elbow
	1 Hr. Pump		1 00		
			57 94		
	BILL WHEN CONNECTED				
9-64	49' 6" Transite pipe				


DATE _____

TOWN OF LEXINGTON — BOARD OF PUBLIC WORKS

SEWER DIVISION

46 Sketch of Service Here

STA. 3+82.5

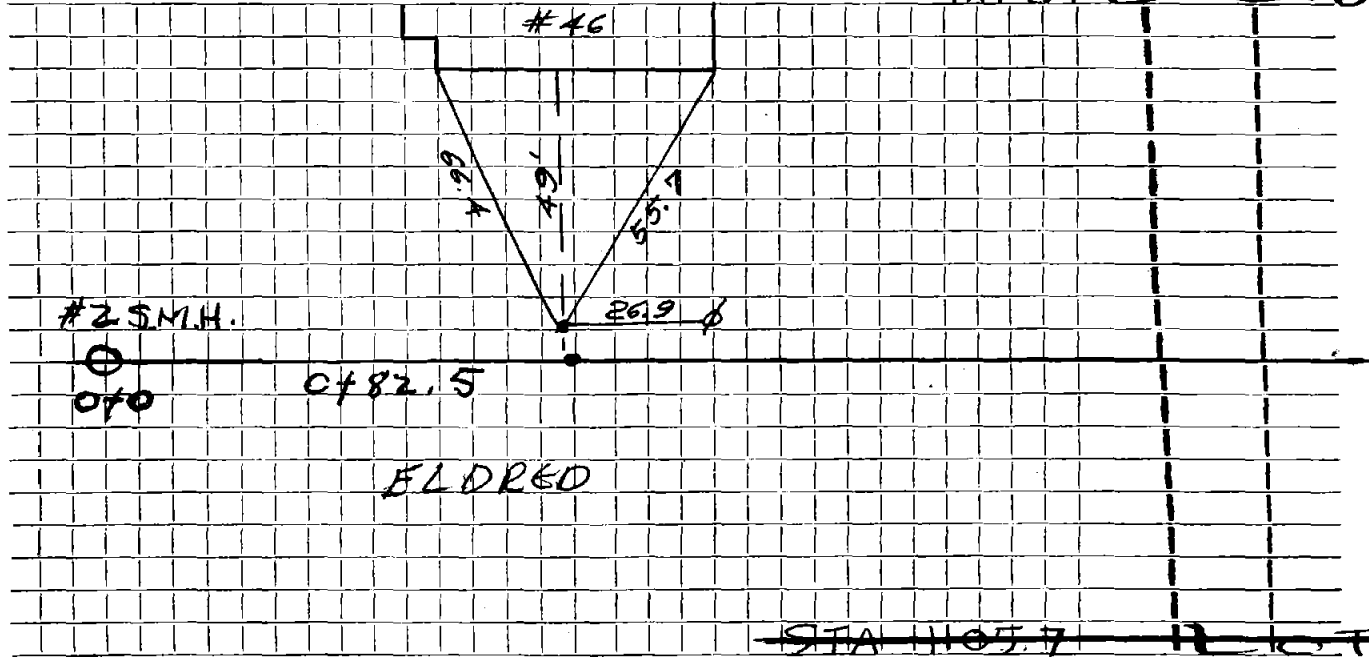

Connection made in Street. Work completed

Remarks:

.....
.....