

Name Harold C. Wilson

Service No. 158

Address 48 Eldred Street

Lot # 390

Location

Kind of Pipe

Size

Size of Main

~~Repair - Renewal~~ New Service

J.M. Lucente Co. Permit #96

Location

DEC 28 1964

Date	Material	Amount	Total	Date	Amount
0-1-59	Labor	24 50		9-14-64	57 94
	10% O. H.	2 45	26 95		
	20' 6" Transite pipe @.70		14 00	10-1-59	
	1 22 1/2" Elbow		2 24		20' 6" Transite
	2 Hrs. Shovel @6.50		13 00		1 6"-22 1/2" Elbow
	1 Hr. Trucking		75		
	1 Hr. Pump		1 00		
			57 94		
	BILL WHEN CONNECTED				
24-64	66' 6" Transite pipe				

DATE _____


TOWN OF LEXINGTON — BOARD OF PUBLIC WORKS

SEWER DIVISION

Sketch of Service Here

48

STA. ~~90~~ 51.7

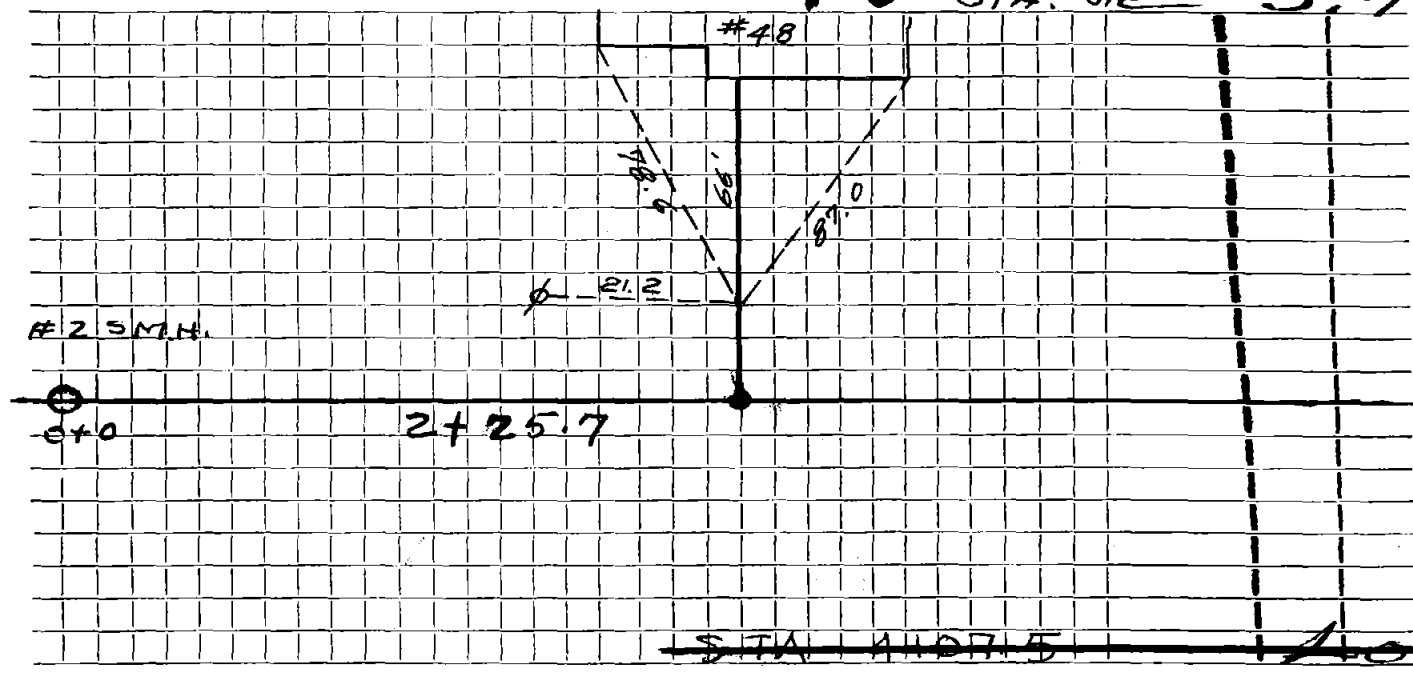

Connection made in Street. Work completed

Remarks:
.....
.....