

Name

Service No.

Address #49 Eldred St.

Lot 387 (See other card)

Location

Kind of Pipe

Size

Size of Main

Repair—Renewal—New Service

Location


Date		Material	Amount		Total		Date		Amount
4-30-	64								
	45								
							10-20-59		
							20'	6" Transite	
							1	6"-22 1/2° Elbow	

DATE _____

TOWN OF LEXINGTON — BOARD OF PUBLIC WORKS

SEWER DIVISION

Sketch of Service Here

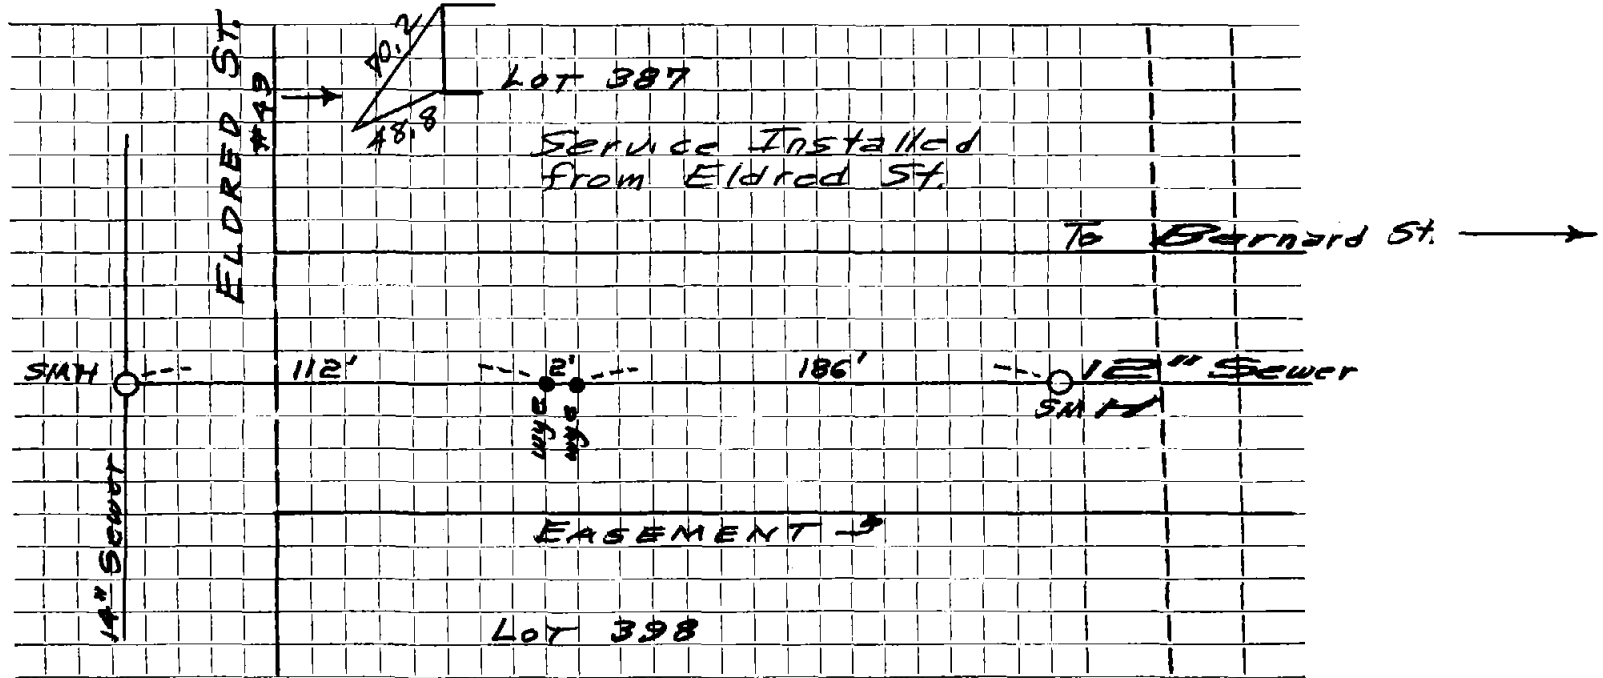

Connection made in Street. Work completed

Remarks: Installed To house by contractor John Devine 4-30-64