

Name **Walter G. Gavin**

Service No. **64**

Address **50 Eldred Street**

Lot # **359**

Location

Kind of Pipe

Size

Size of Main

~~Repts. - Reversible~~ **New Service** **W08013**

Location **Camden 10-28-73**

Date	Material	Amount	Total	Date	Amount
-2-59	Labor	24 50		6-10-63	300 00
	10% O. H.	2 45	26 95	10-28-63	49 59
	20' 6" Transite pipe @.70		14 00		250 41
	1 22 1/2° Elbow		2 24		
	2 Hrs. Shovel @6.50		13 00		
	1 Hr. Trucking		75		
	1 Hr. Pump		1 00		
			57 94		
	BILL WHEN CONNECTED				
3-63	Labor	88.68			
	10% O.H.	8.87	97.55		
	81' 6" Transite pipe @.82		66.42		
	3 hrs. Tow Shovel @6.50		19.50		
	2 hrs. Trucking @3.00		6.00		
	1 hr. Loader @3.00		3.00		
			250.41		
					* Applied 368 to WH #42

DATE _____

TOWN OF LEXINGTON — BOARD OF PUBLIC WORKS


SEWER DIVISION

Sketch of Service Here

50

STA. 6

85.5

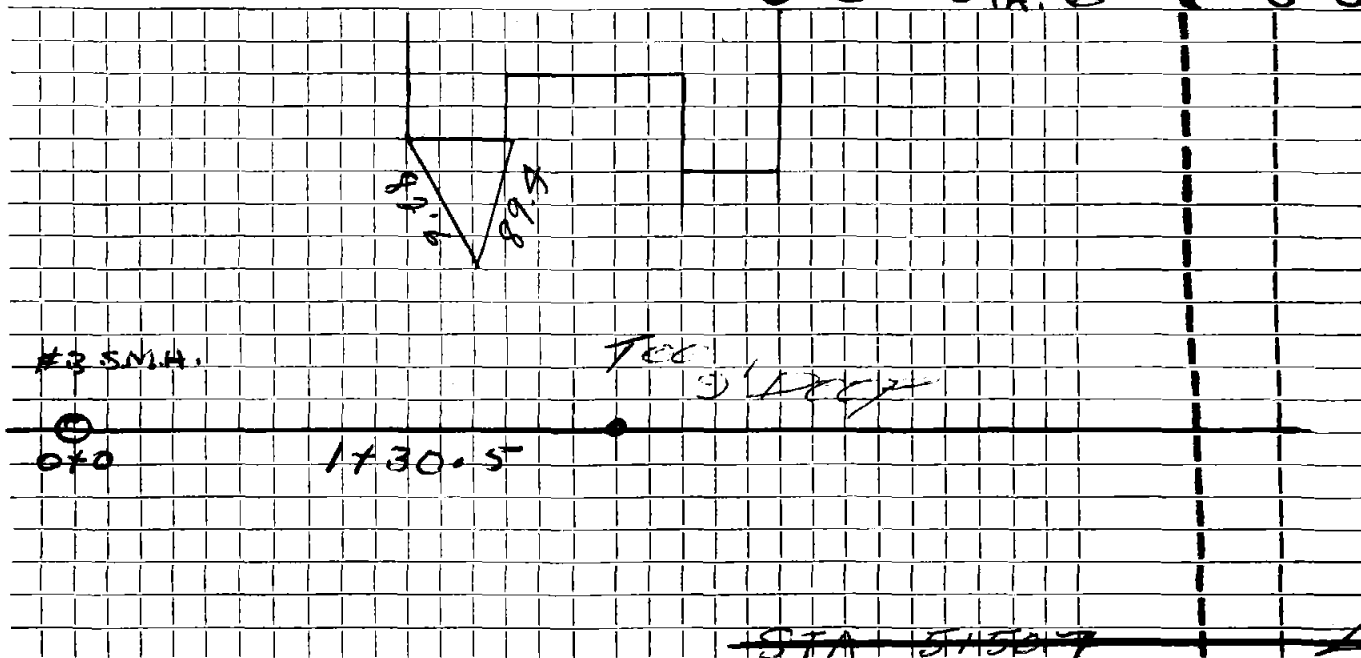

#3 S.M.A.

⊕
070

1730.5

TEE

③ 1730.5

~~STA 54507~~

~~LOT 390~~

Connection made in Street. Work completed

Remarks:
.....
.....