


DATE _____


TOWN OF LEXINGTON — BOARD OF PUBLIC WORKS

SEWER DIVISION


51 Sketch of Service Here


STA. 6+83. 

45' 6" A.C. Sewer Service
From ~~Manhole~~ ^{curb} to House
Installed 5/11/64

0+0

#2
SMH.

1+28.8
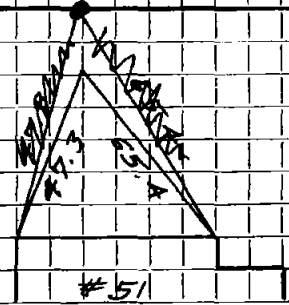
#3 SMH.

2+55



Connection made in Street. Work completed

Remarks:

.....
.....

Name Harold C. Wilson

Service No. 55

Address 51 Eldred Street

Lot 388

Location

Kind of Pipe

Size

Size of Main

Repair—Renewal—New Service

Permit #4 - John Devine

Location Comm 5-18-64


Date	Material	Amount	Total	Date	Amount
0-20-59	Labor	24 50		4-21-64	55.70
	10% O. H.	2 45	26 95		
20	6" Transite pipe @.70		14 00		
	2 Hrs. Shovel @6.50		13 00		
	1 Hr. Trucking		75		
	1 Hr. Pump		1 00		
			55 70		
4-30-64	Installed to house by contractor				
	John Devine				

DATE _____

TOWN OF LEXINGTON — BOARD OF PUBLIC WORKS
SEWER DIVISION

51 Sketch of Service Here

STA. 6+83.8

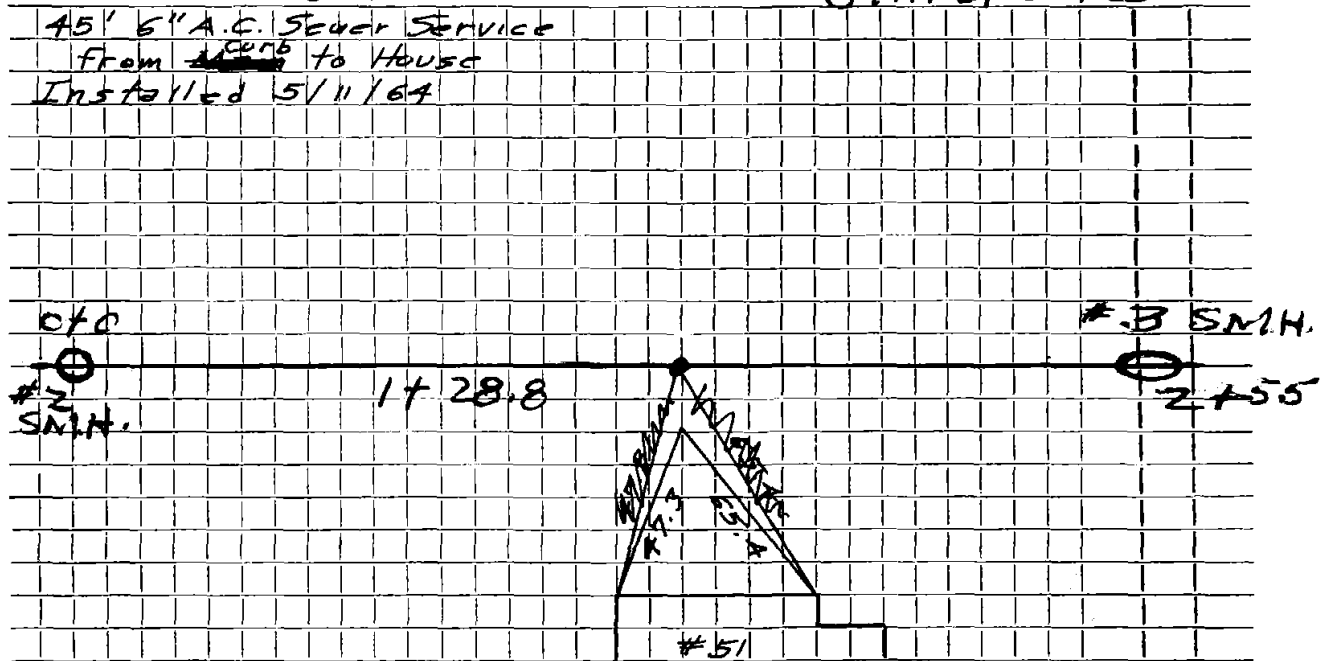

Connection made in Street. Work completed

Remarks:

.....
.....