

Name Diane Estates

Service No. 24

Address 52 Eldred Street

LOT 3

Location

Kind of Pipe

Size

Size of Main

~~Repair~~ ~~Renewal~~ **New Service**

Location Cenon 6-19-61

Date	Material	Amount	Total	Date	Amount
0-3-59	Labor	24 50		4-8-61	Deposit 160.00
	10% O. H.	2 45	26 95	6-19-61	Retard 95
20'	6" Transite pipe @.70		14 00		159.05
2	Hrs. Shovel @6.50		13 00		
1	Hr. Trucking		75		
1	Hr. Pump		1 00		
			55 70 35		
	BILL WHEN CONNECTED				
4-21-61	Labor	32.16			
	10% O.H.	3.22	35.38		
44'	6" Transite pipe @.78		34.32		
10	Ton 1 1/2 Stone @1.50		15.00		
2	Hrs. Town Shovel @6.50		13.00		
2	Hrs. Trucking @3.00		6.00		
			159.05		

DATE _____


TOWN OF LEXINGTON — BOARD OF PUBLIC WORKS

SEWER DIVISION

52

Sketch of Service Here

STA. 8154.3

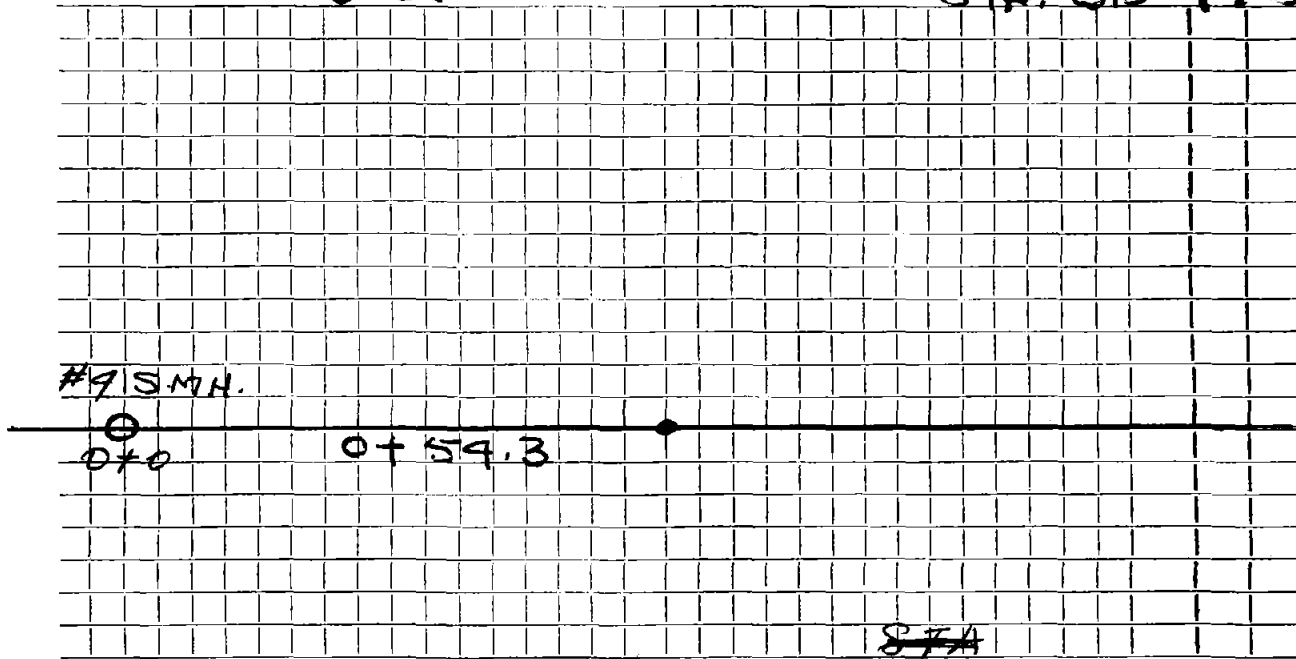

~~SFA~~

Connection made in Street. Work completed

Remarks:

.....
.....