

Name Oscar Carlson

Service No. 67

Address 53 Eldred Street

Lot # 9

Location

Kind of Pipe

Size

Size of Main

~~Repair~~ ~~Renewal~~ **New Service**

Location Comm 7-5-60

Date	Material	Amount	Total	Date	Amount
0-19-59	Labor	24 50		5-5-60	Deposit 150 00
	10% O. H.	2 45	26 95	9-5-60	Retard 5 90
17'	6" Transite pipe @.70		11 90		144 10
2	Hrs. Shovel @6.50		13 00		
1	Hr. Trucking		75		
1	Hr. Pump		1 00		
			53 60		
	BILL WHEN CONNECTED				
5-18-60	Labor	32.60			
	10% O.H.	3.26	35.86		
43'	6" Transite pipe @.78		33.54		
1	11 1/4" Transite Bend		5.10		
2	hrs. Town Shovel @6.50		13.00		
1	hr. Trucking @3.00		3.00		
			144.10		

DATE _____


TOWN OF LEXINGTON — BOARD OF PUBLIC WORKS

SEWER DIVISION

53

Sketch of Service Here

STA. 8+52.0
STA. 9+90 + 6

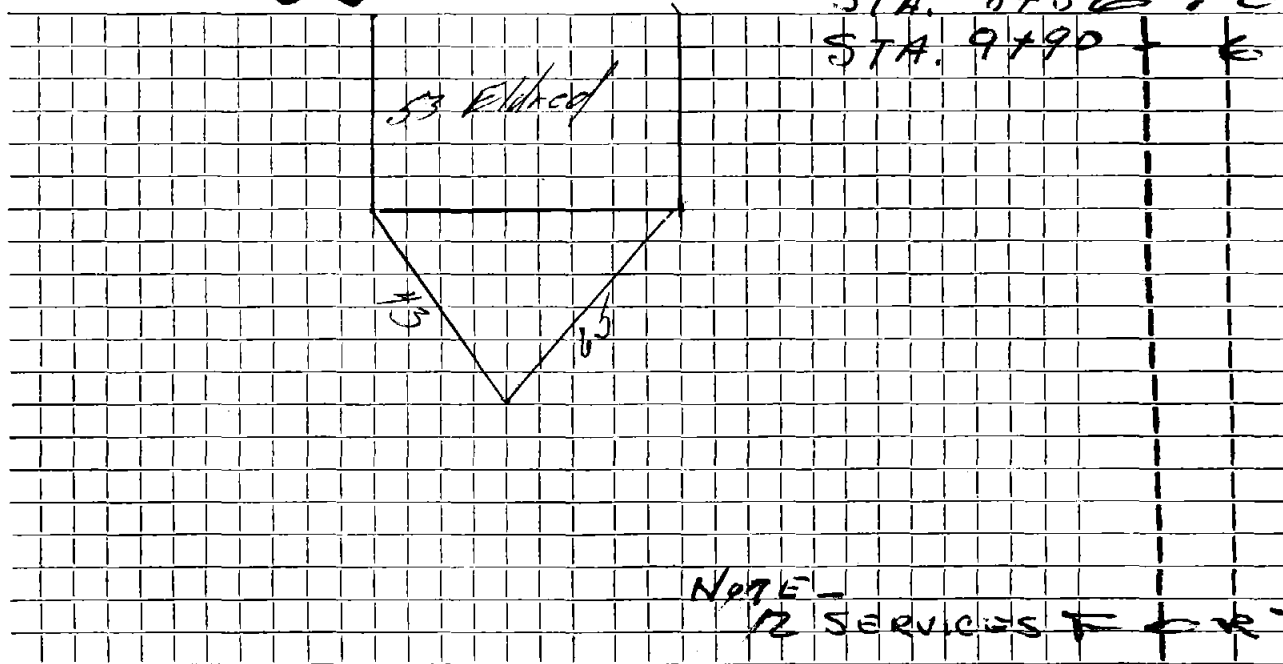

Connection made in Street. Work completed

Remarks:

.....
.....