

Name Oscar Carlson

Service No. 131

Address 54 Eldred Street

Lot # 2

Location

Kind of Pipe

Size

Size of Main

~~Repair~~ ~~Renewal~~ **New Service**

Location *Comm 8-22-60*

Date	Material	Amount	Total	Date	Amount
0-3-59	Labor	24 50		7-25-60	125 00
	10% O. H.	2 45	26 95	8-12-60	22 80
	20' 6" Transite pipe @.70		14 00	9-8-60	8 40
	2 Hrs. Shovel @6.50		13 00		196 46
	1 Hr. Trucking		75		
	1 Hr. Pump		1 00		
			55 70		
	BILL WHEN CONNECTED				
-21-60	Labor	36 60			
	10% O.H.	3 66	40 26		
	38' 6" Transite pipe@.78		29 64		
	1 11 $\frac{1}{4}$ " Transite bend		5 10		
	3 Hrs. Town shovel@6.50		19 50		
	1 Hr. Trucking@3.00		3 00		
	1 Hr. Tro Jan Loader@3.00		3 00		
			196 46		


DATE _____

TOWN OF LEXINGTON — BOARD OF PUBLIC WORKS
SEWER DIVISION

54

Sketch of Service Here

STA. 9+93-0

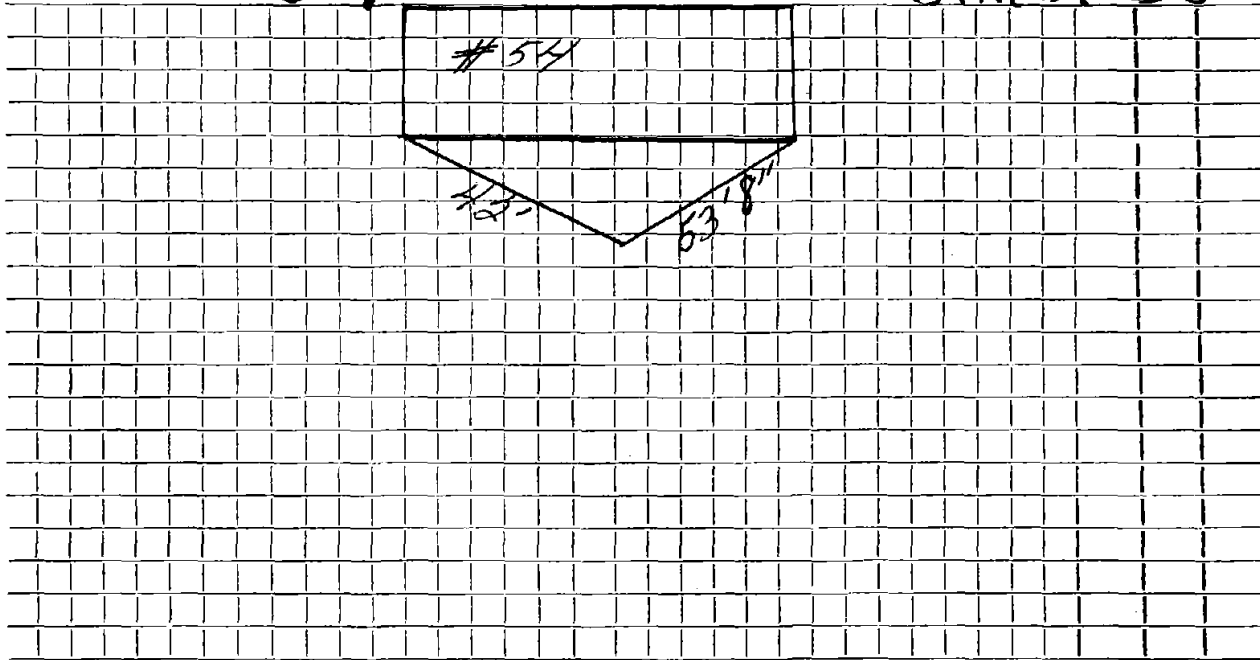

Connection made in Street. Work completed

Remarks:
.....
.....