

Name Oscar Carlson

Service No. 235

Address 55 Eldred Street

Lot # 5

Location

Kind of Pipe

Size

Size of Main

~~REPAIR RENEWAL~~ New Service

Location *Com 2-8-60*

Date	Material	Amount	Total	Date	Amount
0-19-59	Labor	24 50		<i>1-18-59</i>	<i>Deposit</i> 1 50 00
	10% O. H.	2 45	26 95	<i>2-8-60</i>	<i>Returned</i> 9 45
20'	6" Transite pipe @.70		14 00		140 55
2	Hrs. Shovel @6.50		13 00		
1	Hr. Trucking		75		
1	Hr. Pump		1 00		
			55 70		
	BILL WHEN CONNECTED				
2-1-59	Labor	23 74			
	10% O. H.	2 37	26 11		
60'	6" Transite pipe @.70		42 00		
1	6" 11 1/2° Transite elbow		2 24		
2	Hrs. Town shovel @6.50		13 00		
2	Hrs. Trucking @.75		1 50		
			140 55		


DATE _____

TOWN OF LEXINGTON — BOARD OF PUBLIC WORKS

SEWER DIVISION

Sketch of Service Here

STA. 11+29.2

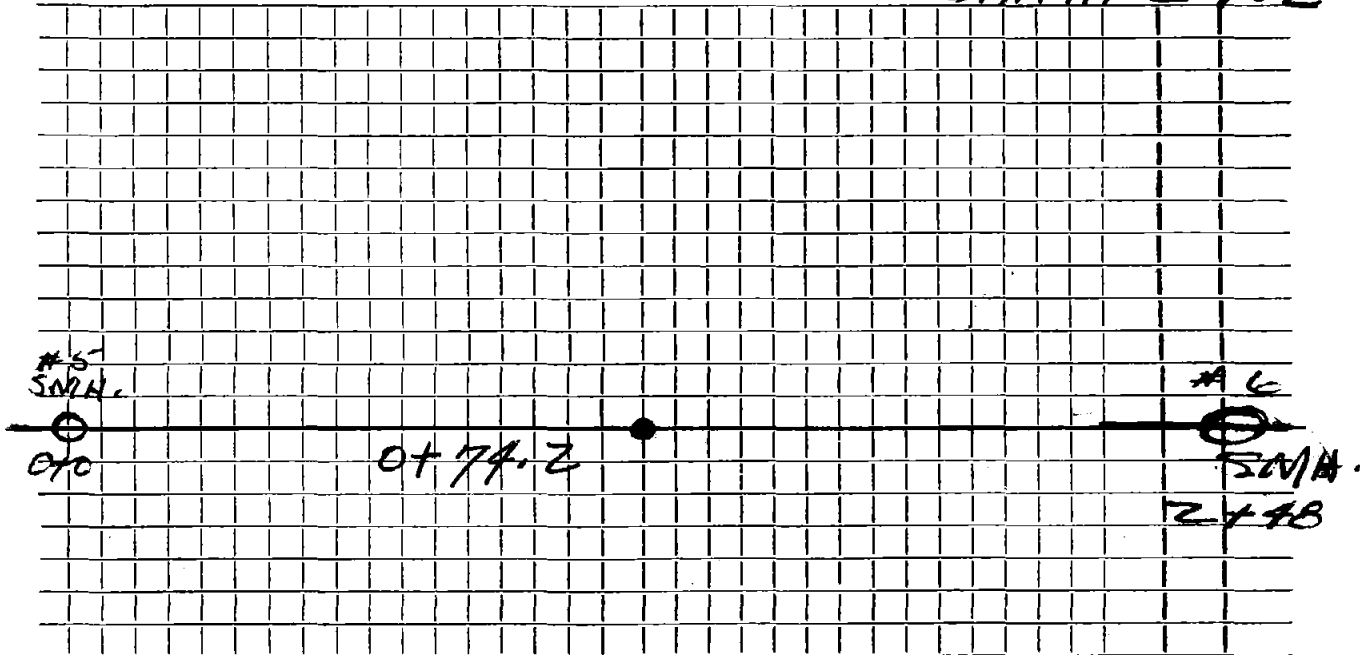

Connection made in Street. Work completed

Remarks:

.....
.....