

Name

Service No.

Address 58 ELDred Street

Location

Kind of Pipe

Size

Size of Main

~~Repair Renewal~~ New Service

Location


Date	Material	Amount		Total		Date			Amount
0-21-59	Labor	24	50						
	10% O. H.	2	45	26	95				
	18' 6" Transite pipe @.70			12	60				
	2 Hrs. Shovel @6.50			13	00				
	1 Hr. Trucking				75				
	1 Hr. Pump			1	00				
				54	30				
	BILL WHEN CONNECTED								

DATE _____

TOWN OF LEXINGTON — BOARD OF PUBLIC WORKS

SEWER DIVISION

Sketch of Service Here

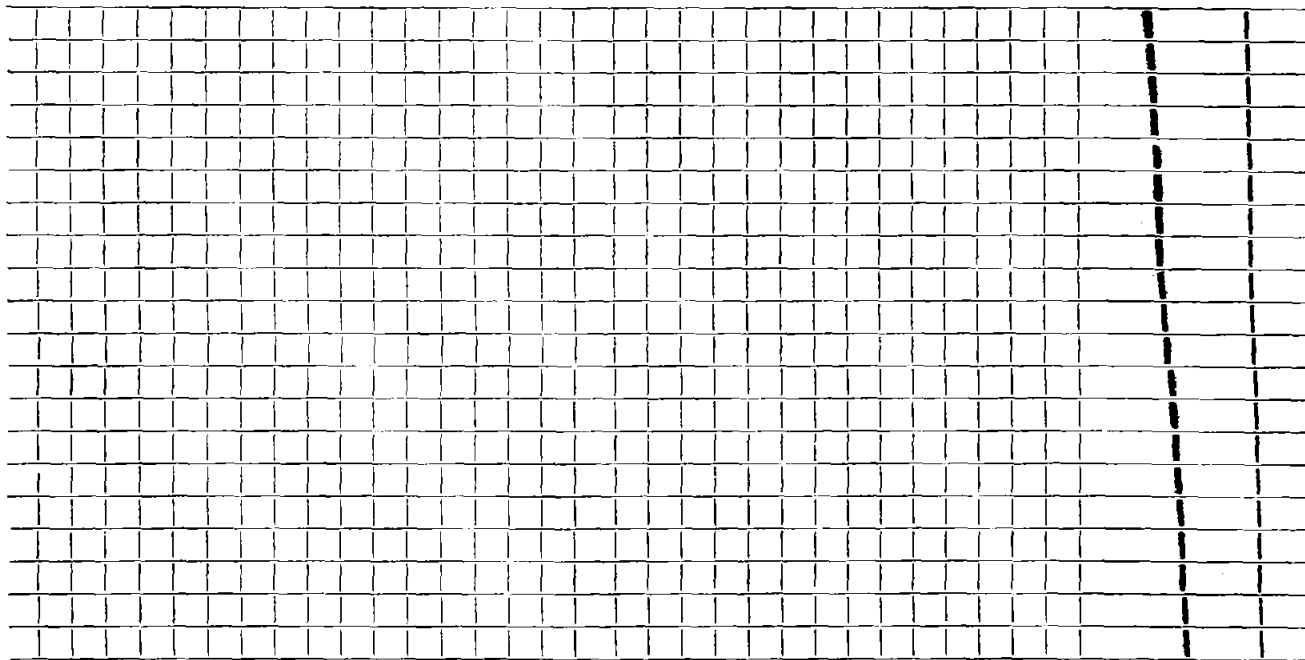

Connection made in Street. Work completed

Remarks:

.....

.....