

Name Helen L. Donovan

Service No. 137

Address 9 Eldred Street

Location

Kind of Pipe

Size

Size of Main

~~Work Order~~ New Service

COM. 11-8-54

Location

Date	Material	Amount	Total	Date	Amount
10/2/54	Labor	52 88		9-15-54	Deposited 125 00
	10% overhead	5 29	58 17	11-8-54	Refunded ( 43
	72' - 6" sewer pipe @ .32		23 04		124 57
	joint compound		4 36	May 7, 1999	Service Blocked \$60
	5 hrs. Littlefield shovel @ 7.50		37 50		in chimney
	2 hrs. trucking @ .75		1 50		
			<u>124 57</u>		

Labor

TOWN OF LEXINGTON—DEPT. OF PUBLIC WORKS

**SEWER DIVISION**

DATE .....

NO. ....


The undersigned applies for the construction of a particular sewer connecting No. ....  
Street and hereby agrees to comply with the Rules and Regulations governing the construction and use of Particular  
Sewers, as now or at any future time established by the Board of Selectmen.

Am't of estimate \$.....

Am't Paid \$.....

..... Owner

**Sketch of Service Here**

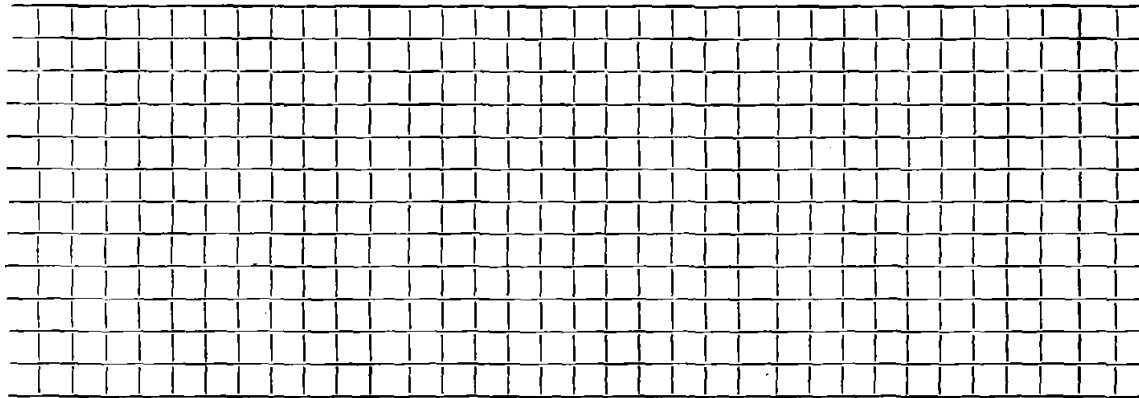

Connection made in ..... Street.

Work completed ..... 19..

Remarks: