

Name John Caloggero

Service No. 24

Address 2 Elena Road

Location

Kind of Pipe

Size

Size of Main

Repair—Renewal—New Service Valeri #564 W.O. #4413

Location

JUL 24 1967


Date	Material	Amount	Total	Date	Amount
5-1-67	Labor 60.00			4-20-67	300 00
5-3-67	" 19.47			7-24-67	58 16
5-4-67	" 17.68	97.15			241 84
	10% O.H.	9.72	106.87	5-1-67	
	41' 6" Transite pipe @.88		36.08	41' 6" Transite	
	1 8 x 6 Service Saddle		5.25	1 6"-22 1/2" Bend	
	1 22 1/2" Transite Bend		4.09	1 8" x 6" Saddle	
	9 ton Stone @1.10		9.90		
	9 ton Gravel @1.10		9.90		
	2 ton Tar Patch @5.50		11.00		
	41 x 5 Reinforcement wire		5.00		
	1 yd cement		13.75		
	4 ton Hot top @5.00		20.00		
	4 ton Binder @5.00		20.00		
			241.84		
5-13-67	25' 6" Transite pipe				
.B.M.18501	10' 4" Cast Iron pipe				

DATE _____

TOWN OF LEXINGTON — BOARD OF PUBLIC WORKS
SEWER DIVISION

Sketch of Service Here

2

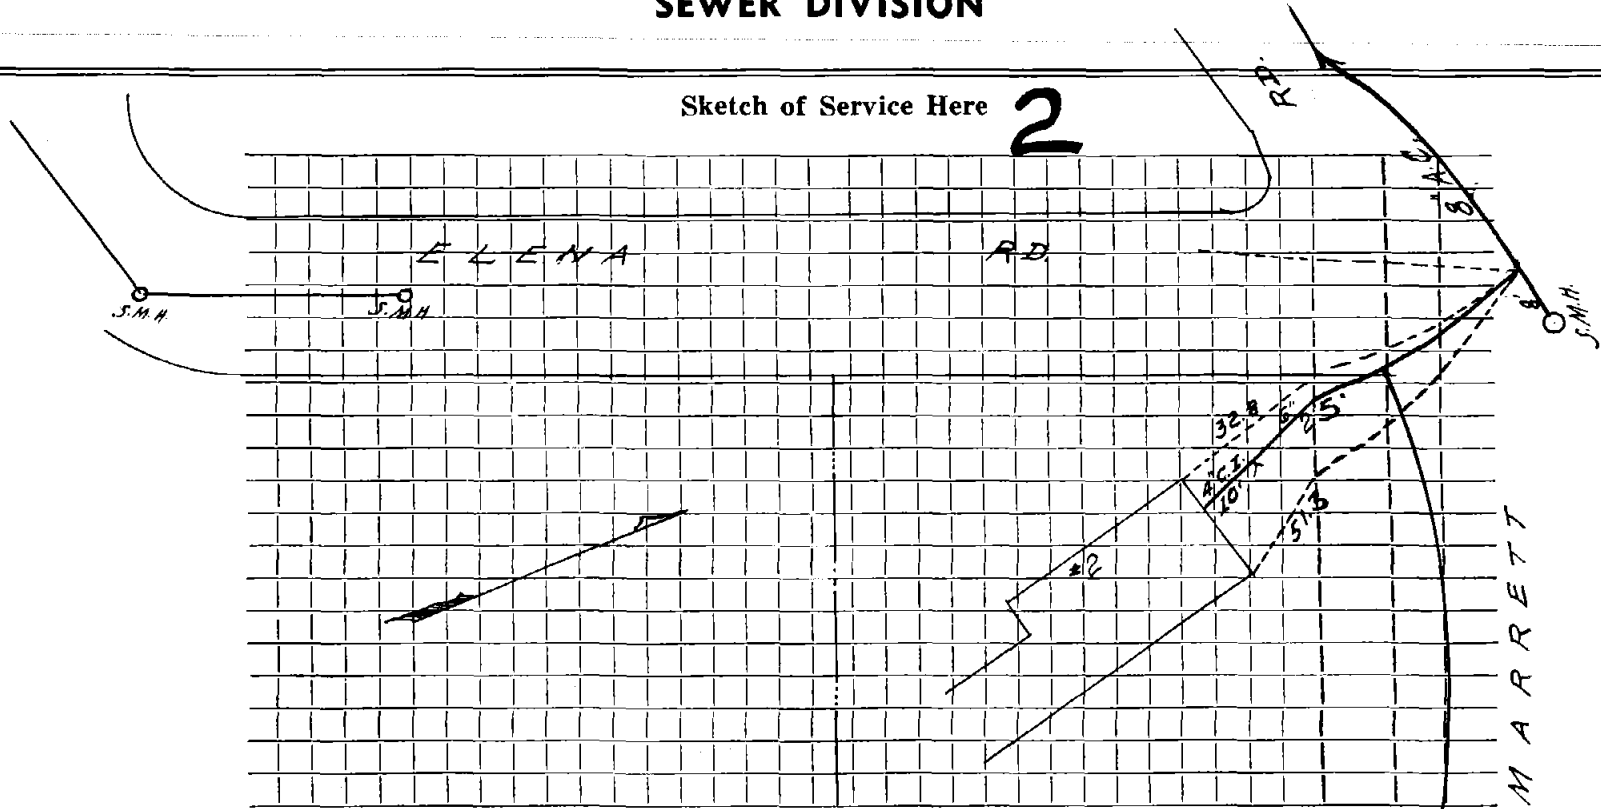

Connection made in Street. Work completed

Remarks:

.....
.....