

Name R. J. Foley Realty

Service No.

Address 6 Elena Road

Lot #9

Location

Kind of Pipe

Size

Size of Main

Repair—Renewal—New Service

DeFlice Bros. #513

Location


Date		Material	Amount	Total	Date	Amount
1/3/67	27'	6" Transite pipe				

DATE _____

TOWN OF LEXINGTON — BOARD OF PUBLIC WORKS

SEWER DIVISION

Sketch of Service Here **6**

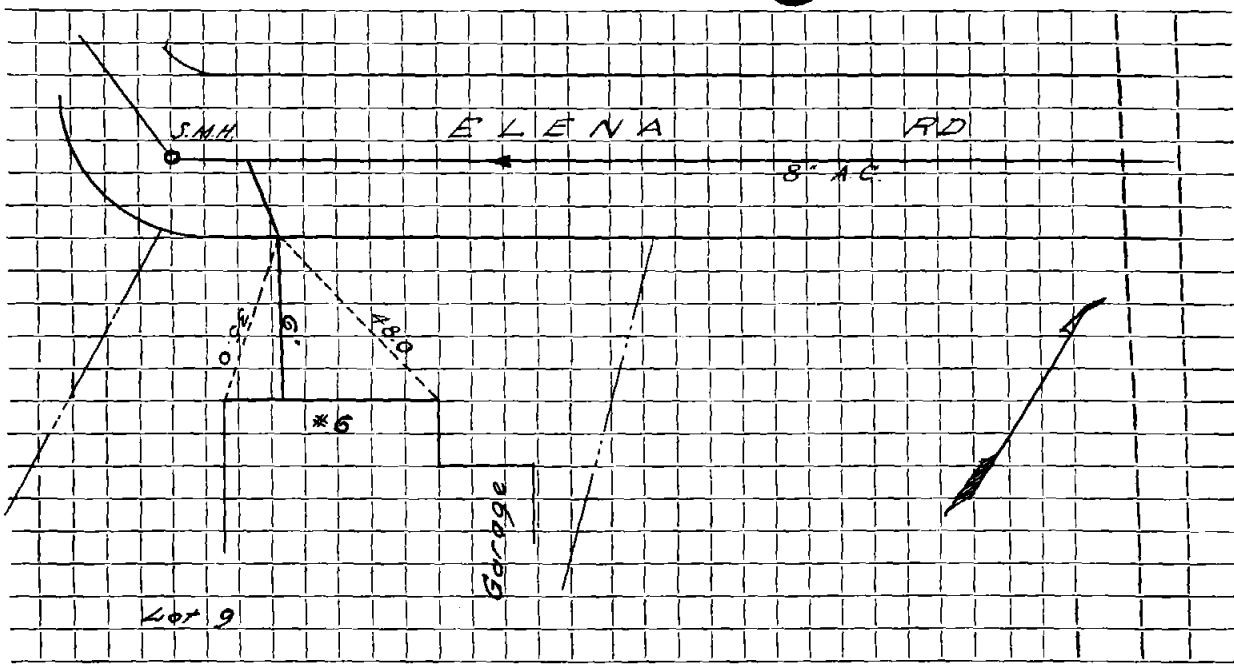

Connection made in Street. Work completed

Remarks:
.....
.....