


DATE 4/30/2020

TOWN OF LEXINGTON — BOARD OF PUBLIC WORKS
SEWER DIVISION

Sketch of Service Here

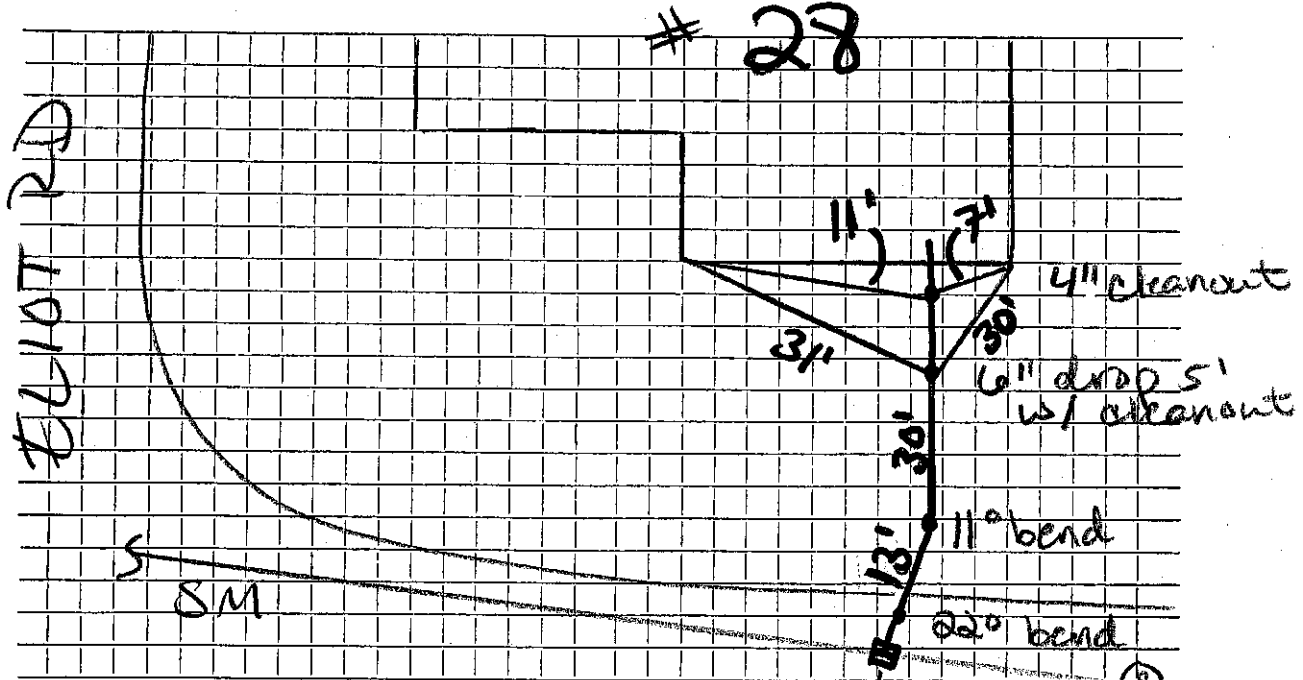

Connection made in Bennington Rd Street. Work completed Saddle 6"

Remarks: 8' cover @ foundation 7' top of main