

Name Richard E. Saulnier

Service No. 20

Address 19 Eliot Road

Location

Kind of Pipe

Size

Size of Main

~~Repair/Renewal~~ — New Service

COM. 5-3-54

Location

| Date    | Material  | Amount | Total  | Date    | Amount           |
|---------|---|--------|--------|---------|------------------|
| 3/30/54 | Labor   | 38 08  |        | 3-18-54 | Deposited 400 00 |
| 3/31/54 | "   | 134 99 |        | 5-4-54  | Refunded (255 67 |
| 4/1/54  | "   | 52 40  |        |         | 344 33           |
|         | 10% overhead  | 225 47 | 248 02 |         |                  |
|         | 24' - 6" Sewer pipe @.3087                                | 22 55  | 7 41   |         |                  |
|         | Joint compound  |        | 1 44   |         |                  |
|         | 1 hr #36 Compressor @2.75                                 |        | 11 00  |         |                  |
|         | 8 hr #37 " @1.75  |        | 14 00  |         |                  |
|         | 1 hr Littlefield shovel @7.50                             |        | 30 00  |         |                  |
|         | 9 lbs Dynamite @.24                                       |        | 2 16   |         |                  |
|         | 20 Exploders @.14   |        | 2 80   |         |                  |
|         | 1 hr trucking @3.00                                       |        | 12 00  |         |                  |
|         | 2 hr trucking @.75  |        | 1 50   |         |                  |
|         | Patching 14 x 3   |        | 14 00  |         |                  |
|         |   |        | 344 33 |         |                  |
|         | 1" Cast iron pipe supplied & laid<br>by owner on property |        |        |         |                  |

**TOWN OF LEXINGTON—DEPT. OF PUBLIC WORKS**  
**SEWER DIVISION**

DATE.....

NO.....


The undersigned applies for the construction of a particular sewer connecting No.....  
Street and hereby agrees to comply with the Rules and Regulations governing the construction **and use** of Particular  
Sewers, as now or at any future time established by the Board of Selectmen.

Am't of estimate \$.....

Am't Paid \$.....

..... Owner

**Sketch of Service Here**

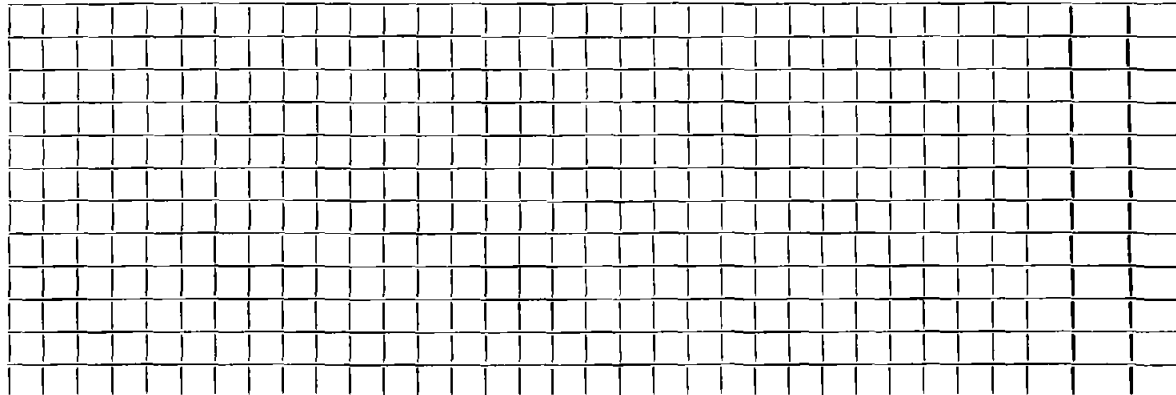

Connection made in..... Street.

Work completed.....19..

Remarks: