

Name Mr. Minot

Service No. 149

Address 22 Eliot Road

Location

Kind of Pipe

Size

Size of Main

~~Repair~~ ~~Renewal~~ ~~→~~ ~~New Service~~

Location *Comm 8-22-60*


Date	Material	Amount	Total	Date	Amount
2-60	Labor	108.16		7-27-60	250.00
3-60	" "	108.16	216.32	9-12-60	69.53
	10% O. H.	21.63	237.95		319.53
	50' 6" Transite pipe@78		39.00		
	1 1 1/4" Transite Bend		5.10		NON CHARGE
	2 1 1/4" EL bows@2.24		4.48	8-4-60	Labor 121.31
	1 Hrs. Trucking@3.00		12.00	8-5-60	" 112.66
	2 Hrs. TroJan Loader@3.00		6.00		233.97
	15 x 3 Patch		15.00		
			319.53		

DATE _____

TOWN OF LEXINGTON — BOARD OF PUBLIC WORKS

SEWER DIVISION

Sketch of Service Here **22**

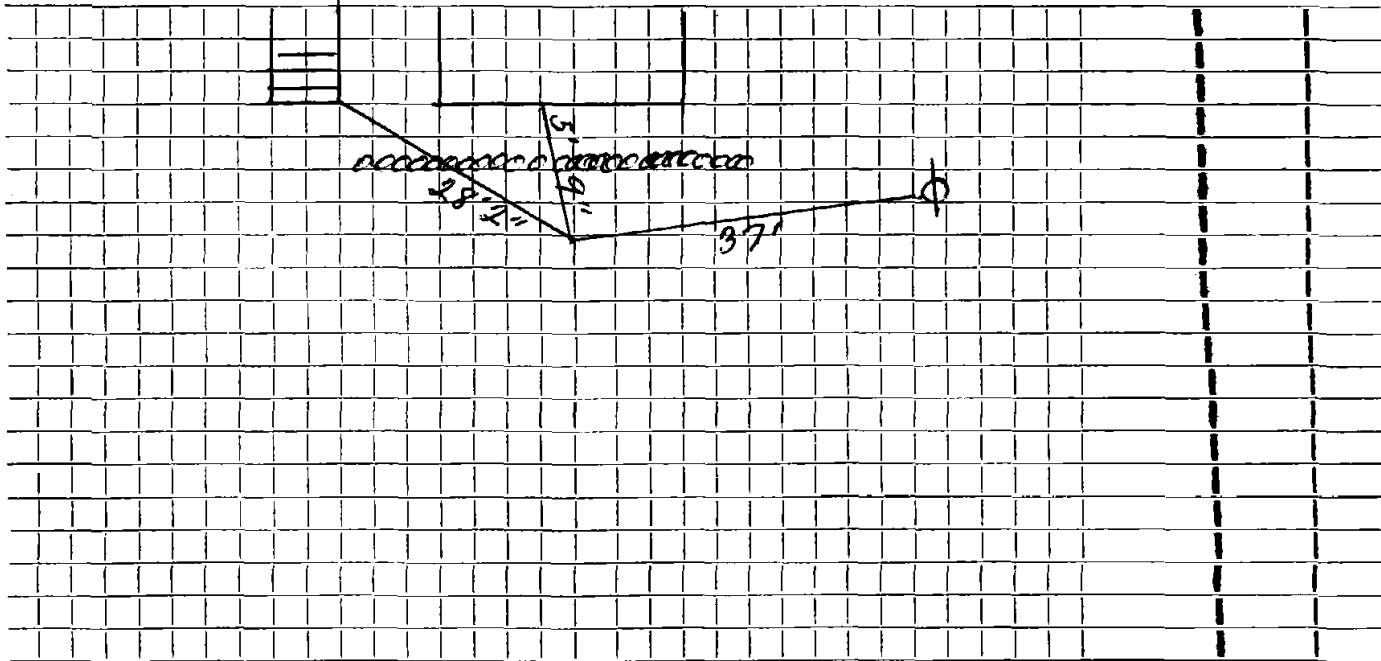

Connection made in Street. Work completed

Remarks: *Sewer Service Renewal*

.....
.....