


DATE _____

TOWN OF LEXINGTON — BOARD OF PUBLIC WORKS
SEWER DIVISION

Sketch of Service Here **27**

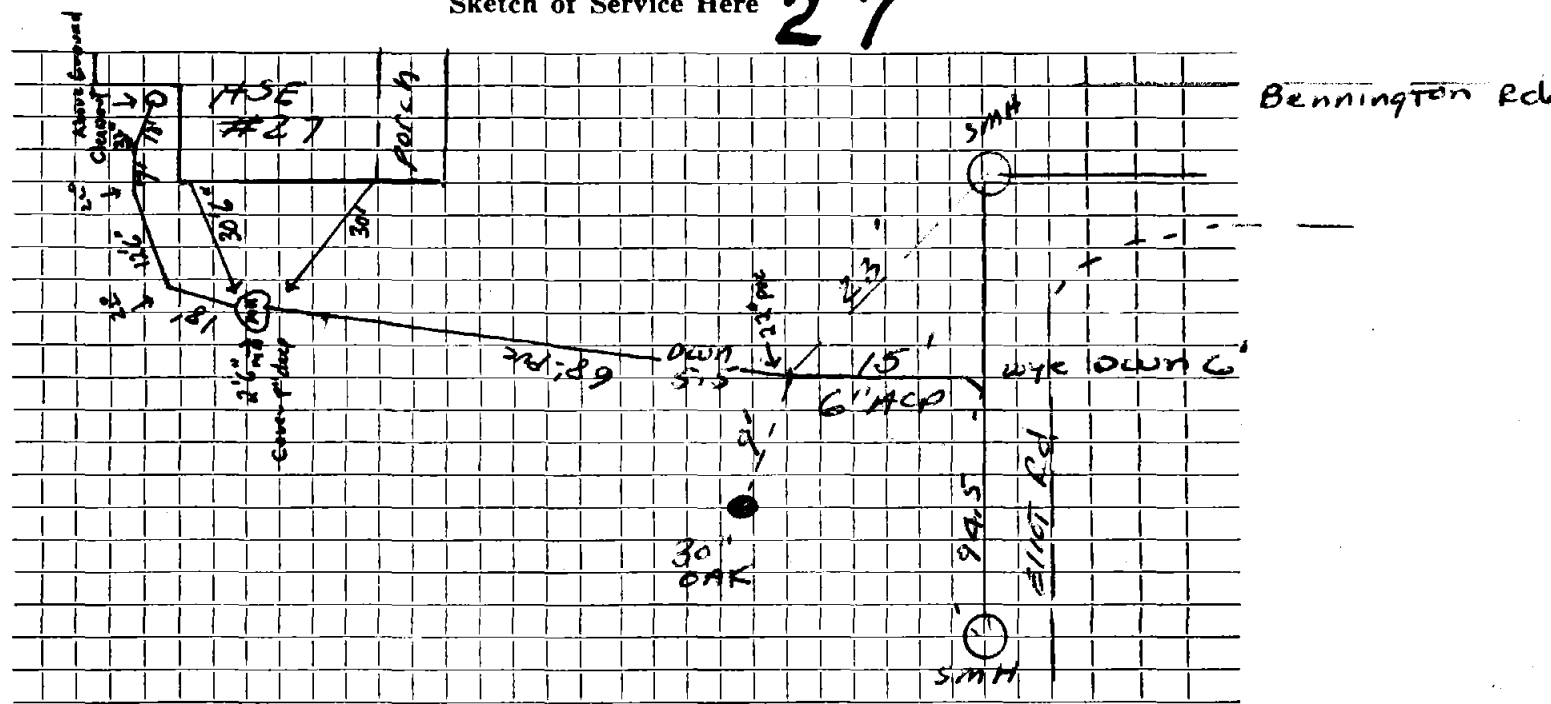

Connection made in Eliot Rd. ~~Street~~ Work completed

Remarks:
.....
.....