




DATE \_\_\_\_\_

**TOWN OF LEXINGTON — BOARD OF PUBLIC WORKS**  
**SEWER DIVISION**

Sketch of Service Here

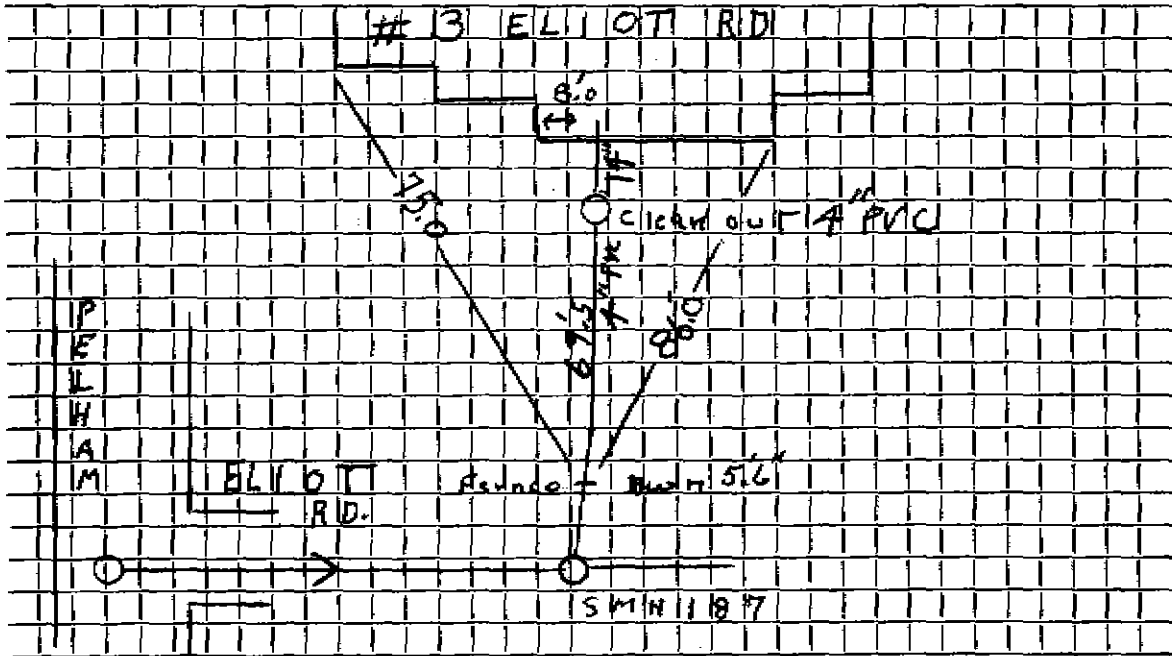

Connection made in Elliott RD..... Street. Work completed 8/19/08 J. McLaughlin.....

Remarks: Clean out 12' 14" inches from foundation.....  
Clay Goes INTO M.H. Flush From M.H.....