

Name

Service No.

Address

32 Eliot Rd

Location

Kind of Pipe

SDR 35 PVC

Size

6"

Size of Main

Repair—Renewal—

New Service

Location

Date

Material

Amount

Total

Date

Amount

5/5/2020

6" insertee
↳ @ clay main

6" SDR 35 PVC 57'


4x6" FernCo

4" cleanout
Sch. 40

DATE 5/5/2020

TOWN OF LEXINGTON — BOARD OF PUBLIC WORKS
SEWER DIVISION

Sketch of Service Here

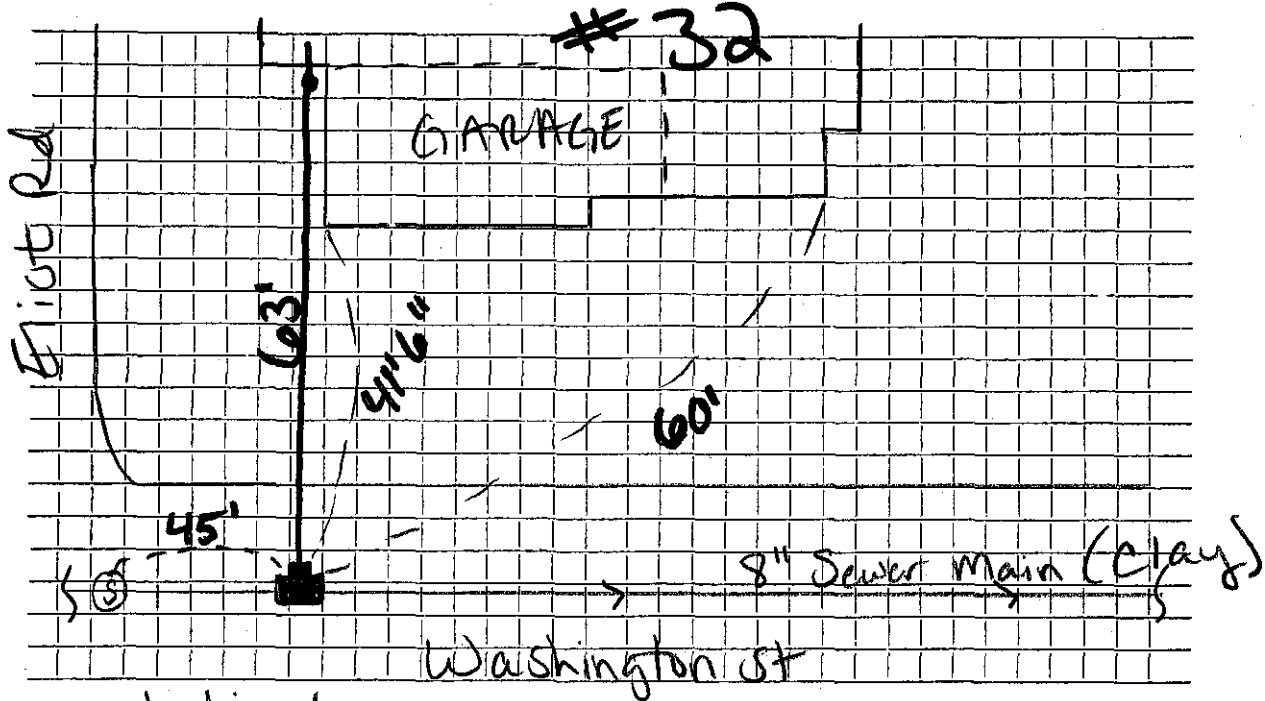

Connection made in Washington Street. Work completed

Remarks:

6" Insert tee depth @ 7'6"
4" Sch. 40 1'6" out from foundation. 4x6" FernCo. 6' out from foundation