

Name Mr. F. W. Dean

Service No. 11 226

Address 4 Eliot Road

Location

Kind of Pipe

Size

Size of Main

~~Repair~~ ~~Renewal~~ New Service

Location

Date	Material	Amount	Total	Date	Amount
9/8/33	114' 6" Sewer Pipe @ .15	17 10			
	1 6" Ell	70			
	3 6" 1/8" Bends @ .70	2 10			
	1 6" Y	70			
	Sulphur & Jute	4 56			
	6 Hrs. Truck. @ .75	<u>4 50</u>	\$29 66		
	106 Hrs. Labor @ .50	53 00			
	8 " " @ .55	4 40			
	51 " " @ .60	<u>30 60</u>	88 00		
	10% Overhead		<u>8 80</u>		
	Labor		126 46		
	ESTIMATED COST	<u>\$115 00</u>	<u>\$115 00</u>		

Sept 6 1933 - Cash

115

9-19-33
Comm. for
115.

Hadley Press, Inc., Lexington

COST
CHARGE

TOWN OF LEXINGTON—BOARD OF PUBLIC WORKS
SEWER DIVISION

DATE Aug. 31, 1933

NO. _____


The undersigned applies for the construction of a particular sewer connecting No. 4 Eliot Road Street and hereby agrees to comply with the Rules and Regulations governing the construction and use of Particular Sewers, as now or at any future time established by the Board of Selectmen.

Am't. of Estimate \$ 115 -

Am't. Paid \$ 115 - 9/6/33

F. W. [Signature] Owner

Sketch of Service Here

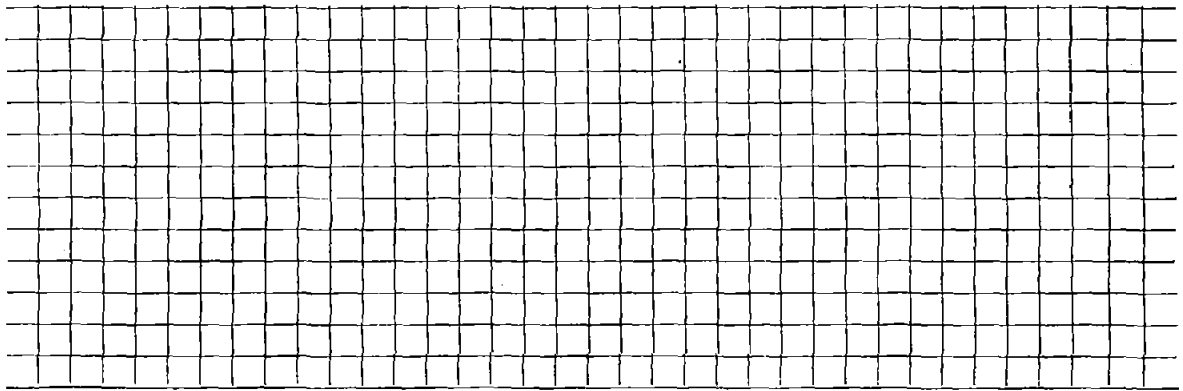


Connection made in _____ Street. Work completed _____ 19

Remarks:

DATE DEC 22 1997

TOWN OF LEXINGTON — BOARD OF PUBLIC WORKS
SEWER DIVISION

Sketch of Service Here

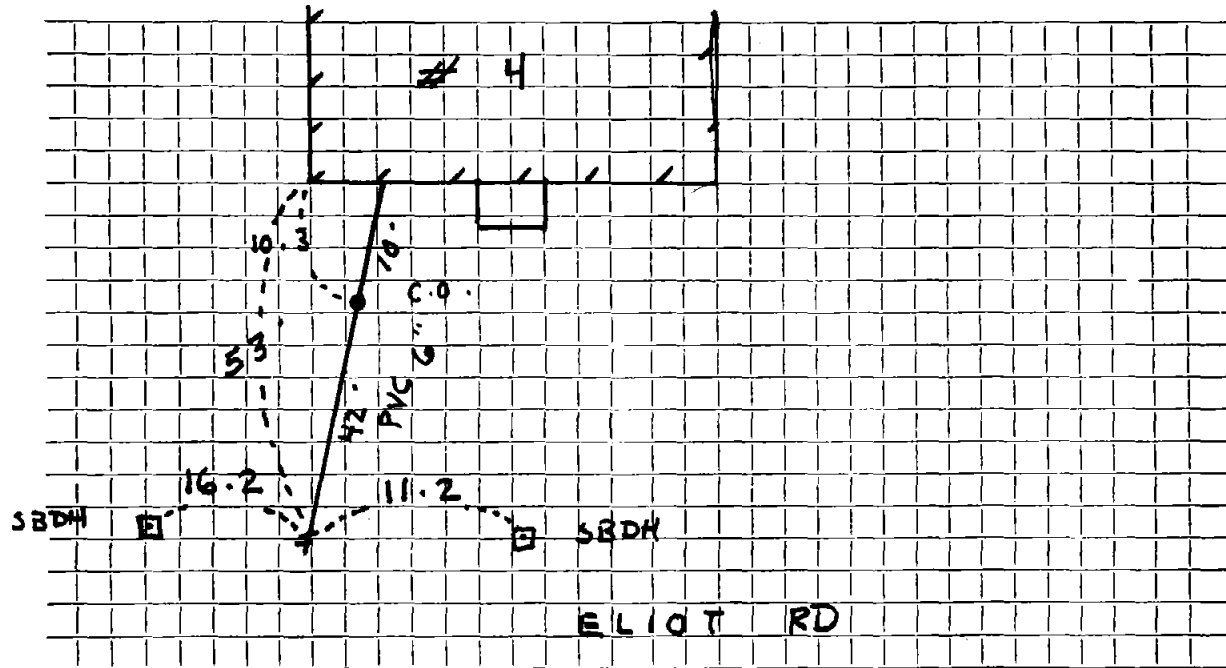

Connection made in ELIOT Street. Work completed ARLEX

Remarks:

FIELD Book 97-5 TJM