

Name

Service No.

Address

Le Fiat Rd

Location

Kind of Pipe

SOR35 PVC

Size

6"

Size of Main

Repair ~~Renewal~~ New Service

Location

Date

Material

Amount

Total

Date

Amount

5/18/2020

4" cleanout sch. 40

4x6" ferro

6" 11 1/4° bend


6" PVC SOR35

6x6" ferro

8' to invert

TOWN OF LEXINGTON — BOARD OF PUBLIC WORKS
SEWER DIVISION

Sketch of Service Here

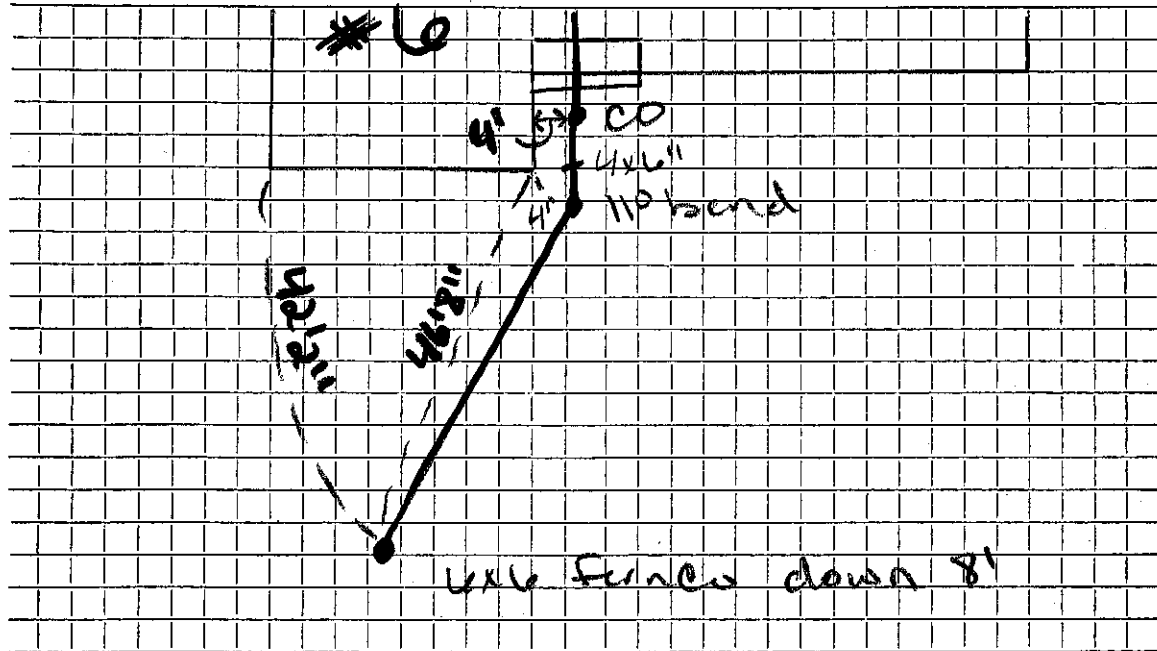

Connection made in Eliot Rd Street. Work completed

Remarks:
 6" - 11' 4" bend to 4x6 ferro = 4'
 4x6 ferro to 4" cleanout = 4'
 4" Cleanout to front steps
 (bottom step) = 2' 6"