


DATE _____

TOWN OF LEXINGTON — BOARD OF PUBLIC WORKS
SEWER DIVISION

Sketch of Service Here **23**

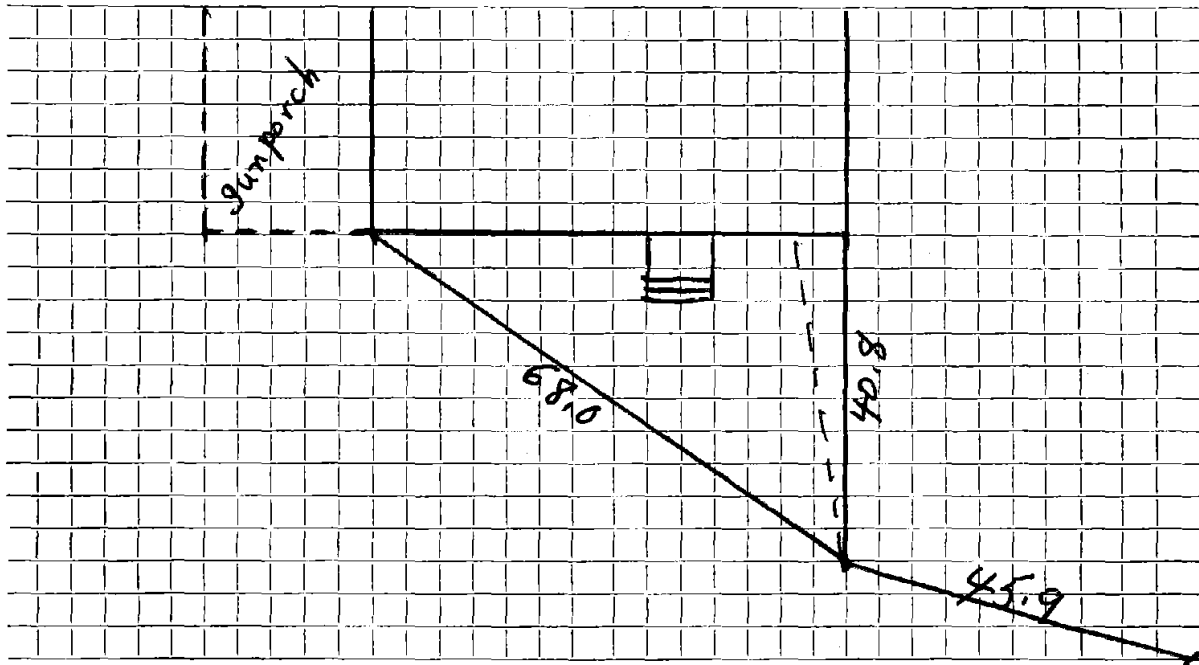

Connection made in Street. Work completed *O.S.M.H.*

Remarks:
.....
.....