


e

DATE 7/19
2019

TOWN OF LEXINGTON — BOARD OF PUBLIC WORKS

SEWER DIVISION

Sketch of Service Here

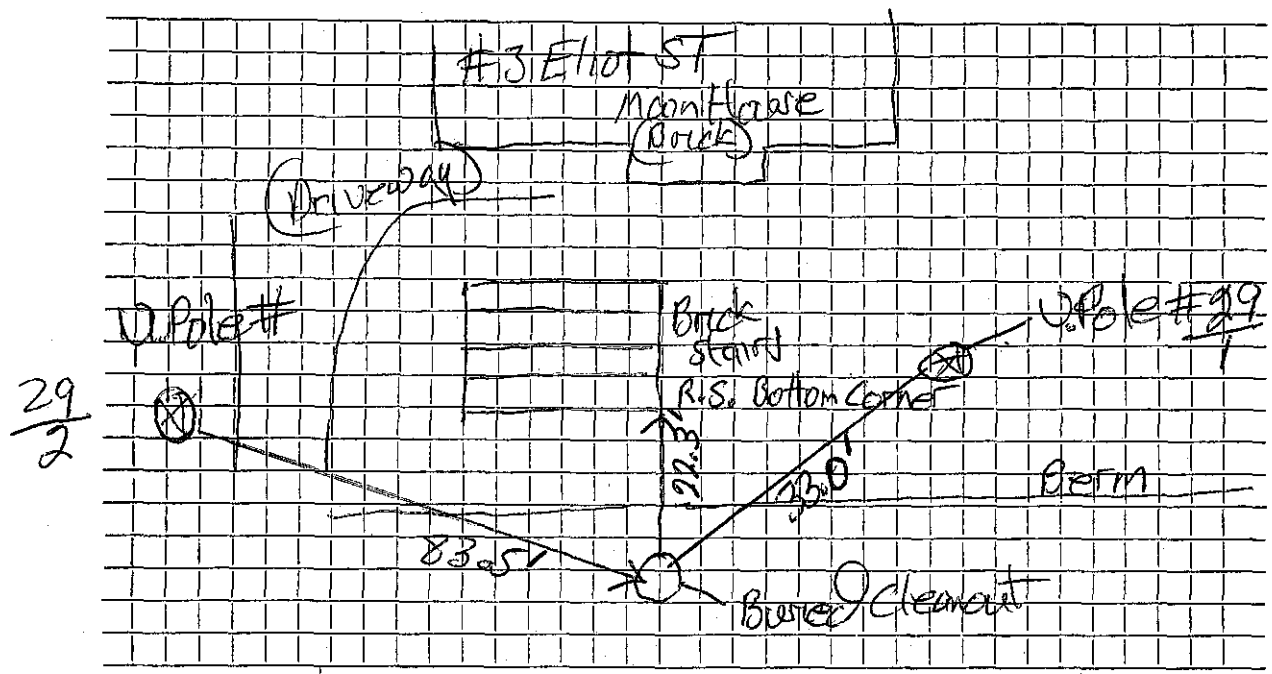

Connection made in Eliot Street. Work completed 7/19

Remarks: Buried in street, stone + fabric on top. Caution Tape on top.