

Name

Service No.

Address 2 ELLEN DANA COURT

Location

Kind of Pipe

Size

Size of Main

Repair—Renewal—New Service

Location

Date

Material

Amount

Total

Date

Amount

~~8/1 94 50' of 6" PVC~~

8-1-94

50' 6" P.V.C.


DATE 8/1/94

TOWN OF LEXINGTON — BOARD OF PUBLIC WORKS

SEWER DIVISION

Sketch of Service Here

2

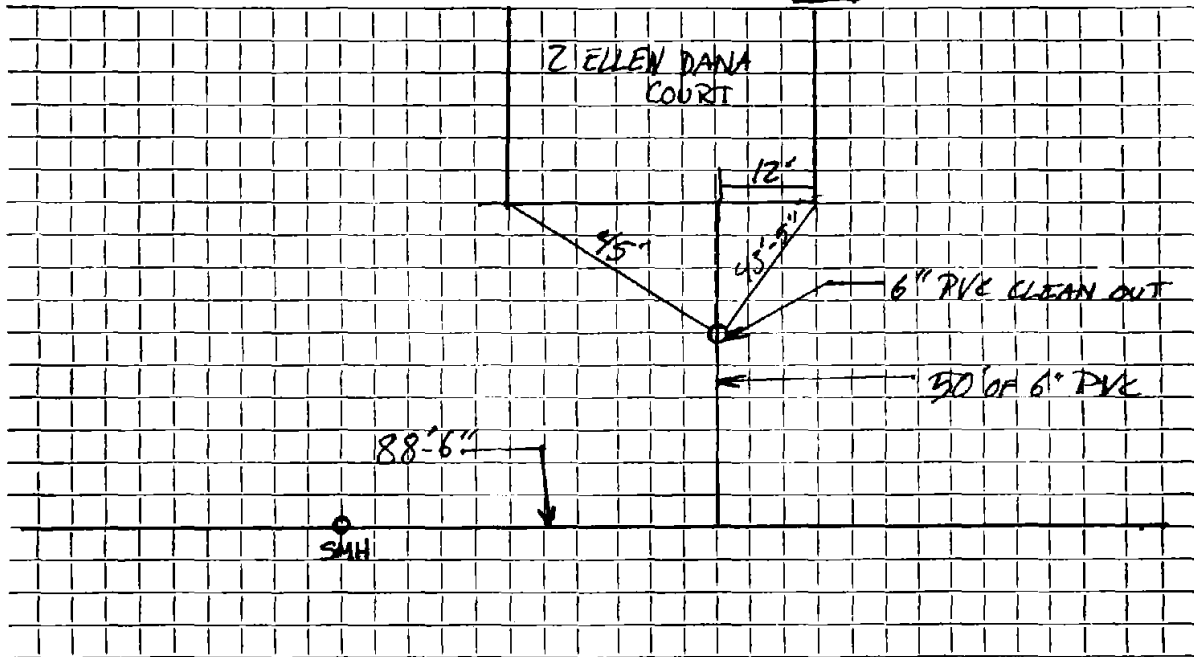

Connection made in ..... Street. Work completed .....

Remarks: .....

.....

.....