

Name Frank A. Eifler

Service No. 117

Address 10 Ellison Rd.

Location

Kind of Pipe

Size

Size of Main

~~Repair~~ ~~Renew~~ ~~XX~~ New Service

Location Comm 11-9-59

Date	Material	Amount	Total	Date	Amount
	<del>20' 6" Transite pipe</del> installed by			7-27-59	150 00
	contractor @3.50		70.00	11-9-59	- 13 00
8-5-59	Labor	71.96		11-27-60	38 77
	10% O.H.	7.20	79.16		188 77
	27' 6" Transite pipe @.70		18.90	20' 6" Transite	
	1 22 1/2° Transite Bend		6.21		
	2 hrs. Town Shovel @6.50		12.60		
	2 hrs. Trucking @.75		1.50		
			<del>201.77</del>		
			188 77		
	<b>Labor</b>				
	2				
					38.77

**TOWN OF LEXINGTON—DEPT. OF PUBLIC WORKS**  
**SEWER DIVISION**

DATE.....

NO. ....


The undersigned applies for the construction of a particular sewer connecting No.....  
Street and hereby agrees to comply with the Rules and Regulations governing the construction and use of Particular  
Sewers, as now or at any future time established by the Board of Selectmen.

Am't of estimate \$.....

Am't Paid \$.....

..... Owner

Sketch of Service Here **10**

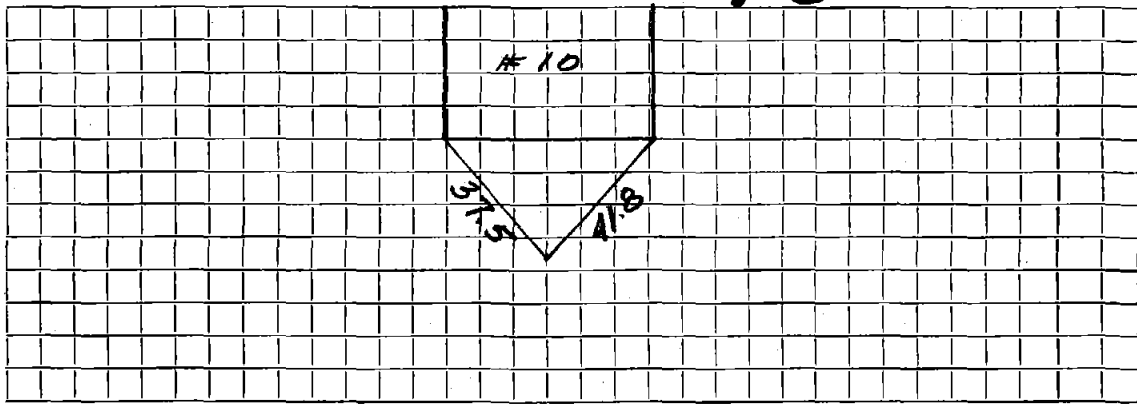

Connection made in..... Street.

Work completed.....19..

Remarks: