

Name John P. Hildreth

Service No. 156

Address 11 Ellison Rd.

Location

Kind of Pipe

Size

Size of Main

~~Repair~~ ~~Renews~~ ~~XXXXXX~~ New Service

Location Comm 12-14-59

Date	Material	Amount	Total	Date	Amount
	<del>20' 6" Transite pipe @ 3.50</del>		70.00	9-1-59	150.00
	(installed by contractor)			9-9-60	15.31
9-29-59	Labor	39.64			165.31
	10% O.H.	3.96	43.60		
	35' 6" Transite pipe @.70		24.50	20' 6" Transite	
	1 6" Transite Bend 22 $\frac{1}{2}$ "		6.21		
	3 hrs. Town Shovel @6.50		19.50		
	2 hrs. Trucking @.75		1.50		
			<u>165.31</u>		
	Labor				

TOWN OF LEXINGTON—DEPT. OF PUBLIC WORKS  
SEWER DIVISION

DATE.....

NO. ....


The undersigned applies for the construction of a particular sewer connecting No.....  
Street and hereby agrees to comply with the Rules and Regulations governing the construction and use of Particular  
Sewers, as now or at any future time established by the Board of Selectmen.

Am't of estimate \$.....

Am't Paid \$.....

..... Owner

Sketch of Service Here

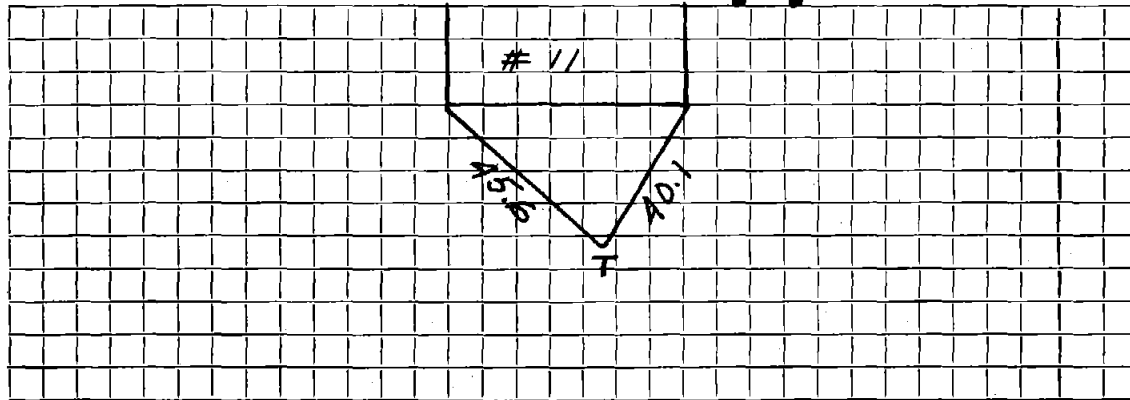

Connection made in..... Street.

Work completed.....19..

Remarks: