


TOWN OF LEXINGTON — BOARD OF PUBLIC WORKS

SEWER DIVISION

Sketch of Service Here

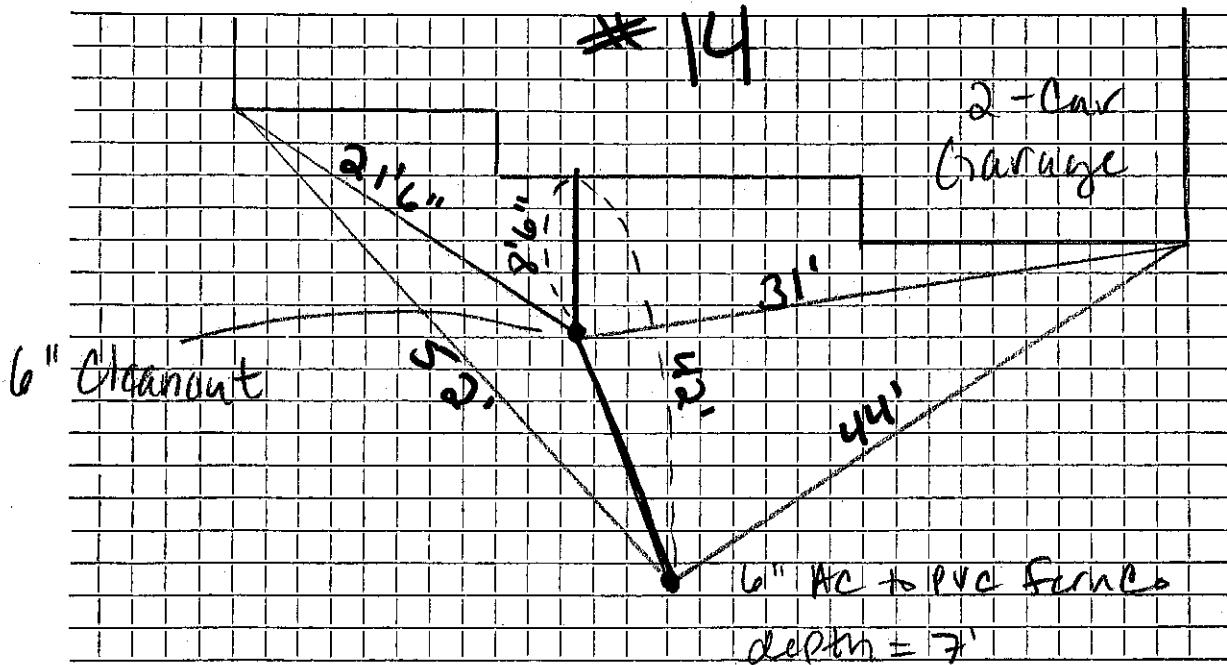

Connection made in ... Ellison Rd ... Street. Work completed

Remarks: depth @ service to stub = 7'