

Name

Service No.

Address

15 Ellison Rd

Location

Kind of Pipe

Size

Size of Main

Repair—Renewal—New Service

Location

Date

Material

Amount

Total

Date

Amount

12600

INSIDE RENEWED

6x6x6 wye clean out


6x6 PVC to AC FERRO

40' - 6" PVC

DATE _____

TOWN OF LEXINGTON — BOARD OF PUBLIC WORKS
SEWER DIVISION

Sketch of Service Here

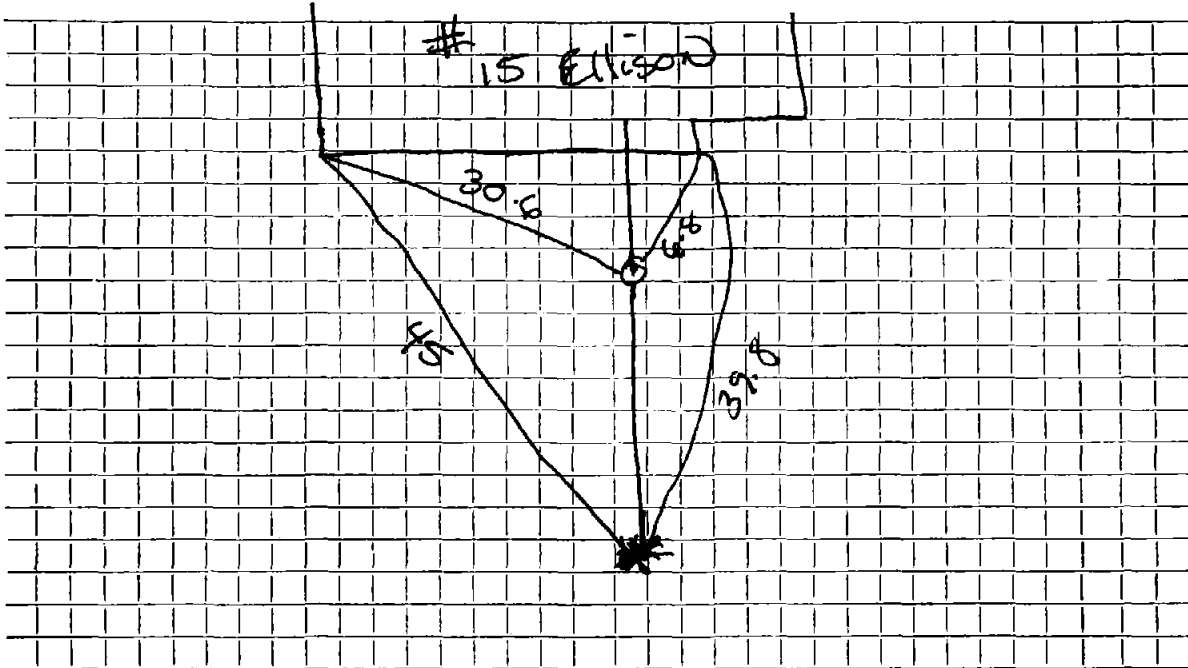

Connection made in Street. Work completed

Remarks:

.....

.....