

Name Richard Perry

Service No. 115

Address 16 Ellison Rd.

Location

Kind of Pipe

Size

Size of Main

~~REPAIR~~ New Service

Location *Com 11-9-59*

Date	Material	Amount	Total	Date	Amount
	20' 6" Transite pipe @ 3.50 (installed by contractor)		70.00	<i>7-24-59</i>	<i>Deposit 150.00</i>
8-3-59	Labor 55.61			<i>12-14-59</i>	<i>Added 13.67</i>
8-4-59	" 39.89	95.50		<i>12-23-59</i>	<i>Paid 56.11</i>
	10% O.H.	9.55	105.05		<i>266.11</i>
	23' 6" Transite pipe @.70		16.10		<i>20' 6" Transite</i>
	1 22 $\frac{1}{2}$ " ^o Transite Elbow		2.24		
	3 hrs. Pippin Shovel @4.50		13.50		
	2 hrs. Trucking @.75		1.50		
	1 hr. Town Shovel @6.50		6.50		
			209.78		
			214.89		
	Labor				

TOWN OF LEXINGTON—DEPT. OF PUBLIC WORKS
SEWER DIVISION

DATE.....

NO.


The undersigned applies for the construction of a particular sewer connecting No.....
Street and hereby agrees to comply with the Rules and Regulations governing the construction and use of Particular
Sewers, as now or at any future time established by the Board of Selectmen.

Am't of estimate \$.....

Am't Paid \$.....

..... Owner

Sketch of Service Here **16**

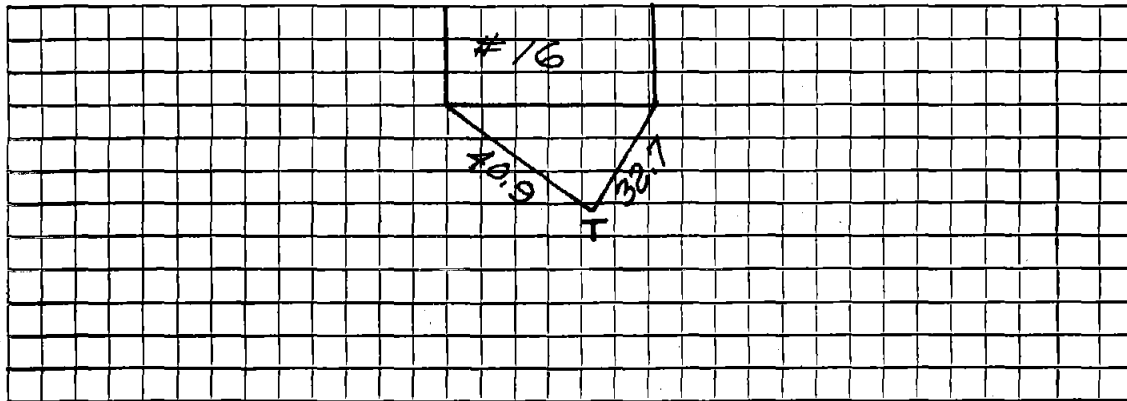

Connection made in..... Street.

Work completed.....19..

Remarks: