

Name Robert McSweeney

Service No. 34

Address 17 Ellison Rd.

Location

Kind of Pipe

Size

Size of Main

~~Repair~~ **New Service**

WC # 7867

Location

(Comm 6-3-63)

Date	Material	Amount	Total	Date		Amount
	<del>20' 6" Transite pipe @3.50</del>		70.00	4-25-63	Deposit	200.00
	(installed by contractor)			6-3-63	Refund	4.61
5-10-63	Labor	74.35				195.39
	10% O.H.	7.44	81.79			
	30' 6" Transite pipe @.82		24.60		20' 6" Transite	
	2 hrs. Town Shovel @6.50		13.00			
	2 hrs. Trucking @3.00		6.00			
			195.39			
	<b>Labor</b>					

TOWN OF LEXINGTON—DEPT. OF PUBLIC WORKS  
SEWER DIVISION

DATE.....

NO.....


The undersigned applies for the construction of a particular sewer connecting No.....  
Street and hereby agrees to comply with the Rules and Regulations governing the construction and use of Particular  
Sewers, as now or at any future time established by the Board of Selectmen.

Am't of estimate \$.....

Am't Paid \$.....

..... Owner

Sketch of Service Here **17**

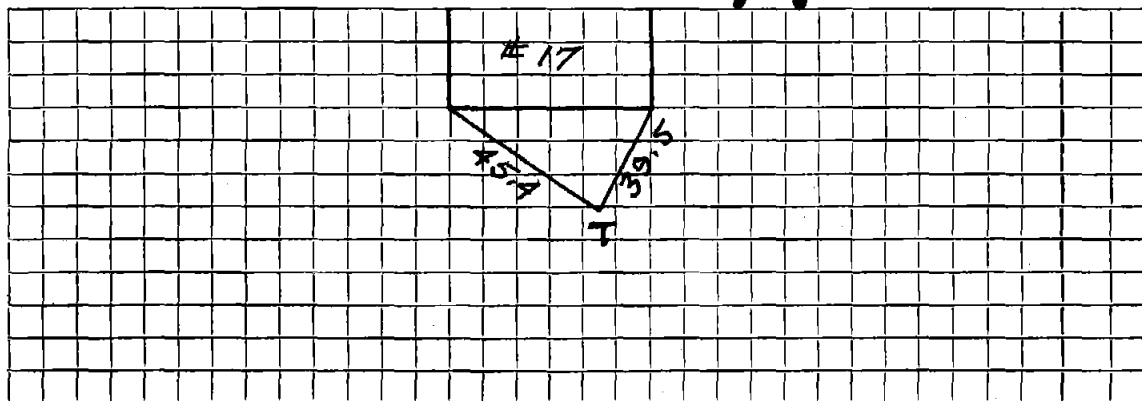

Connection made in..... Street.

Work completed.....19..

Remarks: