

Name Thomas J. Keegan

Service No. 140

Address 18 Ellison Rd.

Location

Kind of Pipe

Size

Size of Main

~~XXXXXX~~ ~~XXXXXX~~ New Service

Location Comm 11-16-59

Date	Material	Amount	Total	Date	Amount
	20' 6" Transite pipe @3.50		70.00	8-20-59	Deposit 150.20
	(installed by contractor)			11-30-59	Paid 30.19
9-1-59	Labor 38.40				180.19
9-2-59	" 14.32	52.72			
	10% O.H.	5.27	57.99		20' 6" Transite
	36' 6" Transite pipe @.70		25.20		
	3 hrs. Town Shovel @6.50		19.50		
	3 hrs. Trucking @.75		2.25		
	3 1/2 ton 1/2" Stone @1.50 ton		5.25		
			180.19		
	Labor				

TOWN OF LEXINGTON—DEPT. OF PUBLIC WORKS
SEWER DIVISION

DATE.....

NO.

The undersigned applies for the construction of a particular sewer connecting No.....
Street and hereby agrees to comply with the Rules and Regulations governing the construction and use of Particular
Sewers, as now or at any future time established by the Board of Selectmen.


Am't of estimate \$.....

Am't Paid \$.....

..... Owner

Sketch of Service Here

18

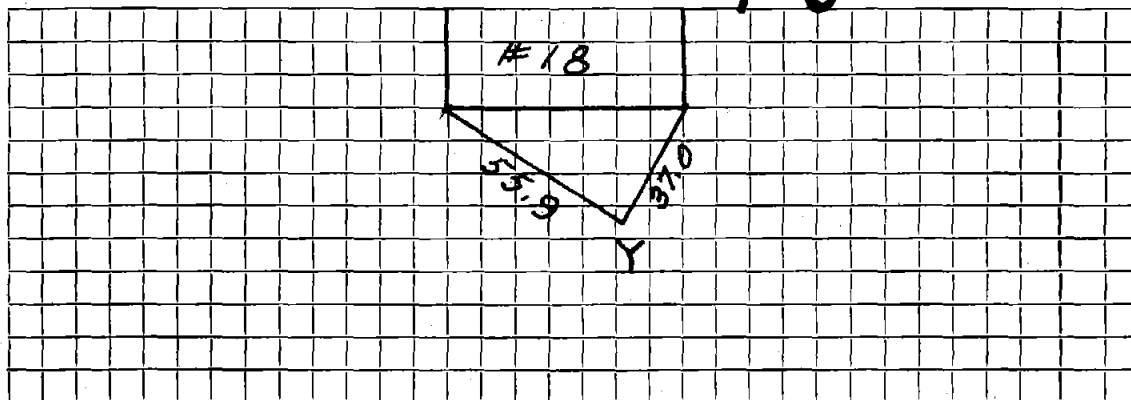

Connection made in..... Street.

Work completed.....19..

Remarks: