

Name Donald Richman  
 Address 20 Ellison Rd

Service No. 163

Location

Kind of Pipe

Size

Size of Main

~~Repair~~ ~~Renew~~ ~~XXXX~~ New Service

Location Comm 12-14-59

Date	Material	Amount	Total	Date		Amount
	<del>30' 6" Transite pipe @3.50</del>			9-8-59	Transit	156.50
	installed by cont.		105.00	2-9-60	Paid	116.43
30-59	Labor	72.03				266.43
	10% O.H.	7.20	79.23		30' 6" Transite	
	55' 6" Transite pipe @.70		38.50	12-18-67	Repair	
	1 Duplex Adapter		1.90		5' 6" Transite	
	1 Cesspool Cover & Frame		10.50			
	2 Bags Cement @1.50		3.00			
	1 Ton Sand @1.00		1.00			
	150 Sewer Bricks @4.20per 100		6.30			
	3 hrs. Town Shovel @6.50		19.50			
	2 hrs. Trucking @.75		1.50			
			266.43			
				8-15-66	Roots	
				11-15-67	Roots	


DATE \_\_\_\_\_

TOWN OF LEXINGTON — BOARD OF PUBLIC WORKS

SEWER DIVISION

Sketch of Service Here

20

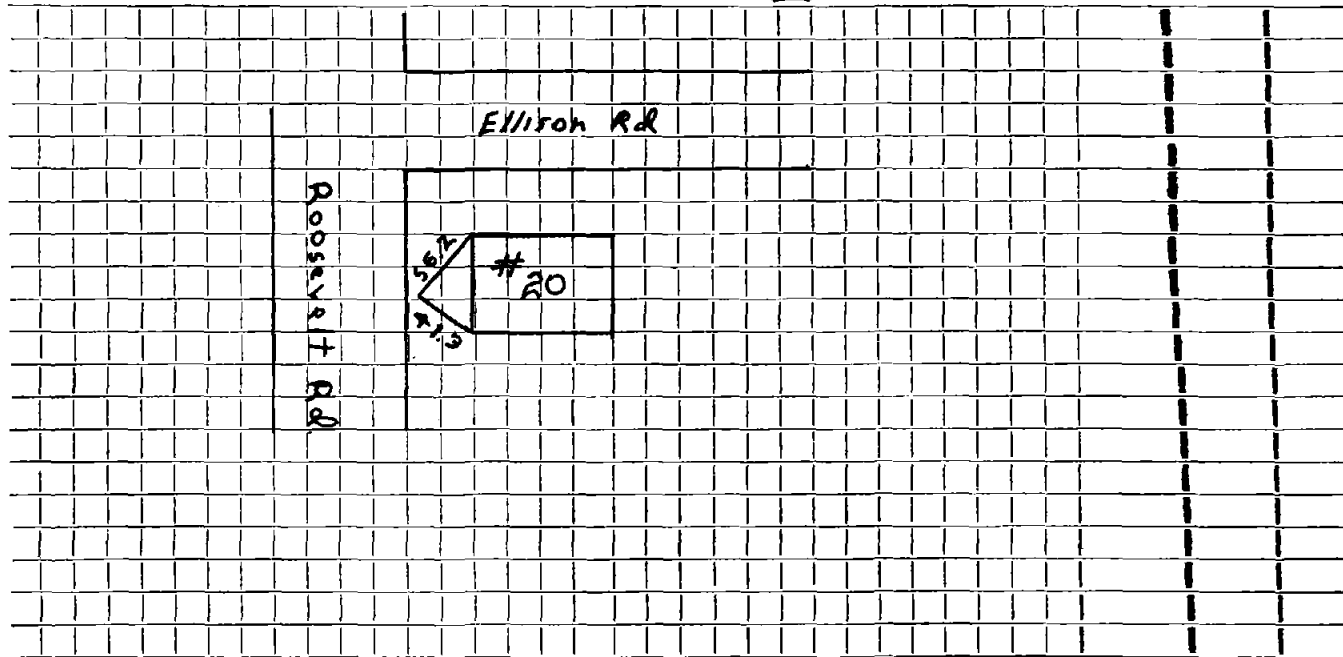

Connection made in Roosevelt Rd Street. Work completed .....

Remarks: .....  
.....  
.....