

Name Cecilia O'Brien

Service No. 103

Address 3 Ellison Road

Location

Kind of Pipe

Size

Size of Main

Repair—Renewal—New Service W.O. #5371 Lucente #755

Location

MAR 18 1968

Date	Inside	Material	Amount	Total	Date	Amount
-12-67	71'	6" Transite pipe			8-24-67	100.00
		outside			4-16-68	19.06
'29/67		Labor	8.09			119.06
'1/67		Labor	16.28			
'6/67		Labor	5.28			
'8/67		Labor	<u>18.51</u>	48 16		
		10% O.H.	4 82	52 98		
	20'	transite pipe @.88		17 60		
	1	8-6 saddle		5 50	3-30-96	80' from clean out
	1	11 1/4 bend		4 09		Respart
	1	22 1/2 elbow		4 09		
	1	ton hot top		5 80		
	5 1/2	hrs. trucking @3.00		16 50		
	1/2	hr. loader @ 4.00		2 00		
	1	hr. shovel @6.50		6 50	1/2	hr. roller @ 3.00
	1/2	hr. compressor @5.00		2 50		1 50
						119 06


DATE _____

TOWN OF LEXINGTON — BOARD OF PUBLIC WORKS

SEWER DIVISION

Sketch of Service Here

3

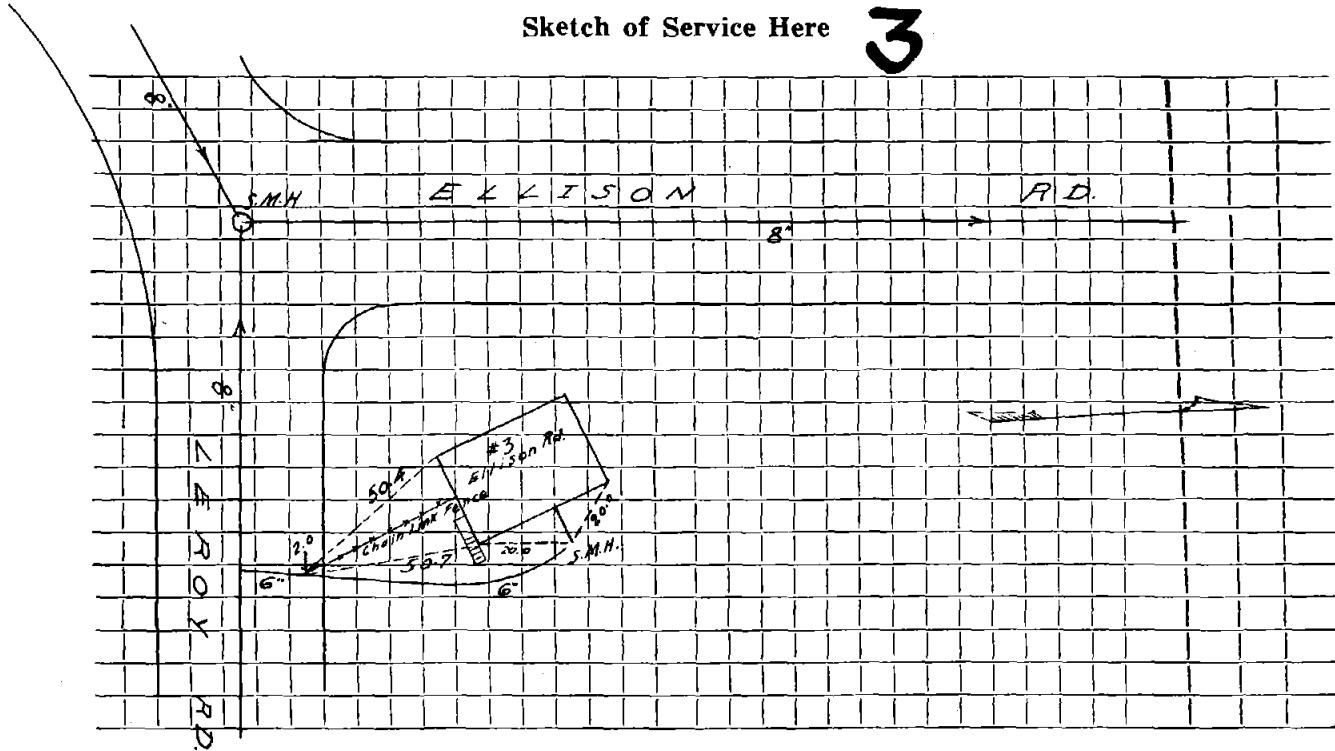

Connection made in Street. Work completed

Remarks:


.....
.....

DATE 9/4/92

TOWN OF LEXINGTON — BOARD OF PUBLIC WORKS

~~SEWER~~ DRAIN DIVISION

Sketch of Service Here

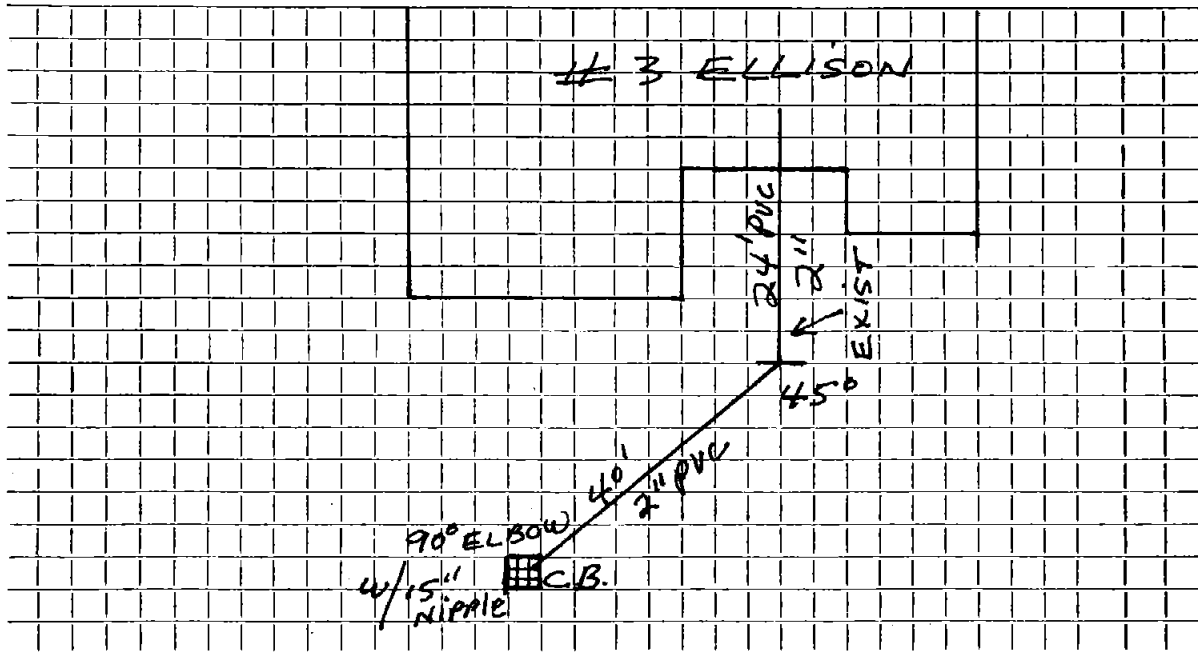

Connection made in #3 ELLISON Street. Work completed 9-4-92

Remarks: BY: SUBURBANITE, INSPECTED: CRG

NOTE: DRAIN TIE