




DATE \_\_\_\_\_

TOWN OF LEXINGTON — BOARD OF PUBLIC WORKS

SEWER DIVISION

Sketch of Service Here

8

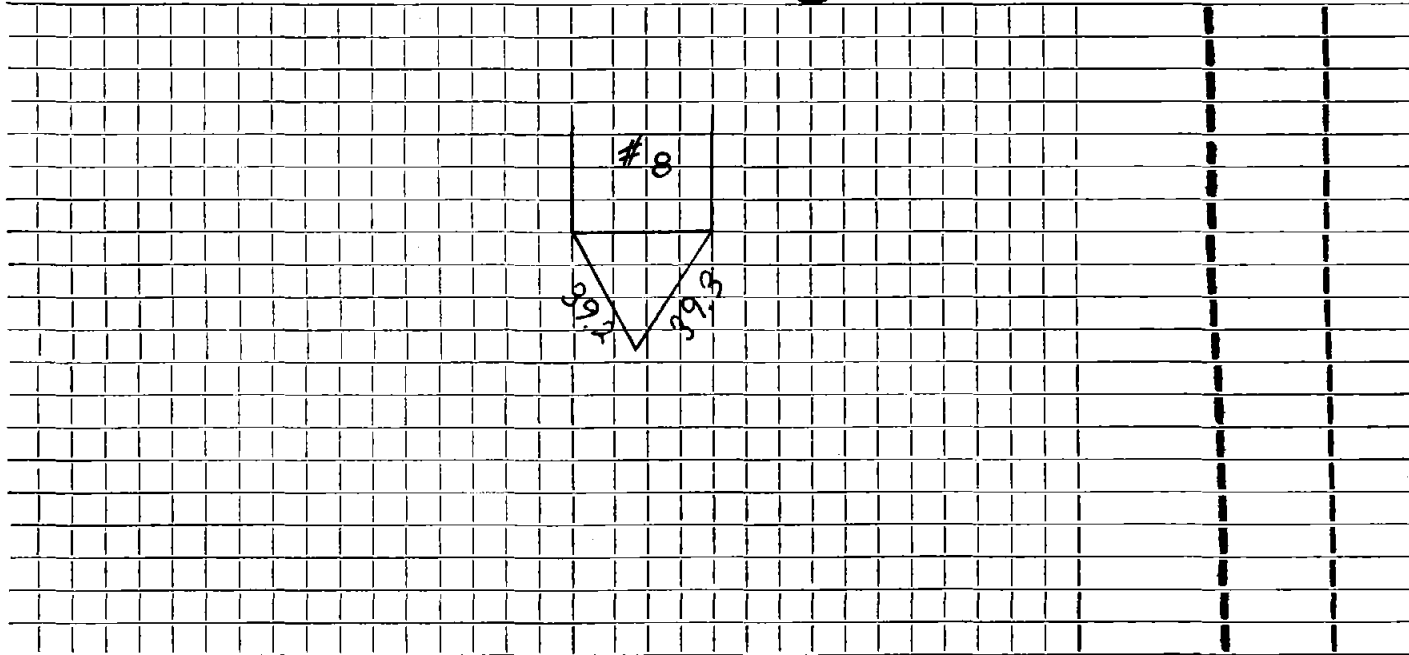

Connection made in Ellisoh Rd Street.

Work completed .....

Remarks: .....

.....  
.....