

Name Thomas M. Connelly

Service No. 177

Address 9 Ellison Rd.

Location

Kind of Pipe

Size

Size of Main

~~Repair~~ ~~Renew~~ New Service

Location Conn 12-14-59

Date	Material	Amount	Total	Date	Amount
	<del>20' 6" Transite Pipe</del> @3.50 (installed by contractor)		70.00	9-16-59	150.00
				1-14-60	28.47
10-1-59	Labor	55.34			198.47
	10% O.H.	5.53	60.87		
	38' 6" Transite pipe @.70		26.60	20' 6" Transite	
	3 hrs. Town Shovel @6.50		19.50		
	2 hrs. Trucking @.75		1.50		
			178.47		
	Labor				
	2.01				
				1-5-60	28.47

**TOWN OF LEXINGTON—DEPT. OF PUBLIC WORKS**  
**SEWER DIVISION**

DATE.....

NO.....


The undersigned applies for the construction of a particular sewer connecting No.....  
Street and hereby agrees to comply with the Rules and Regulations governing the construction and use of Particular  
Sewers, as now or at any future time established by the Board of Selectmen.

Am't of estimate \$.....

Am't Paid \$.....

..... Owner

Sketch of Service Here **9**

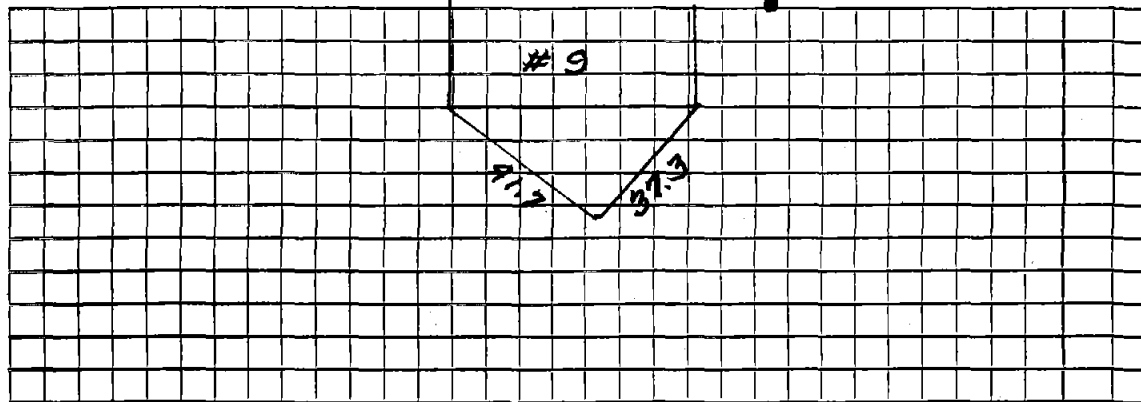

Connection made in..... Street.

Work completed.....19..

Remarks: