

Name Robert Phelan

Service No. 6

Address 12 EMERALD ST.

Location

Kind of Pipe PVC

Size 6"

Size of Main 8" PVC

Repair—Renewal—New Service Redmond #4263

Location SEP 5 1986


Date	Material	Amount	Total	Date	Amount
<del>4-1-85</del>	<del>17 LF 6" PVC</del>	<del>\$ 34.00 =</del>	<del>\$ 578.00</del>	<del>4-14-86</del>	<del>578.00</del>
May '86	42' 6" PVC Pipe				
	10' 4" PVC Pipe				
	1 6" x 4" Fernco			11-1-85	
				17' 6" P.V.C.	

Deposit 578.00

DATE Nov 1985

TOWN OF LEXINGTON — BOARD OF PUBLIC WORKS  
SEWER DIVISION

Sketch of Service Here **12**

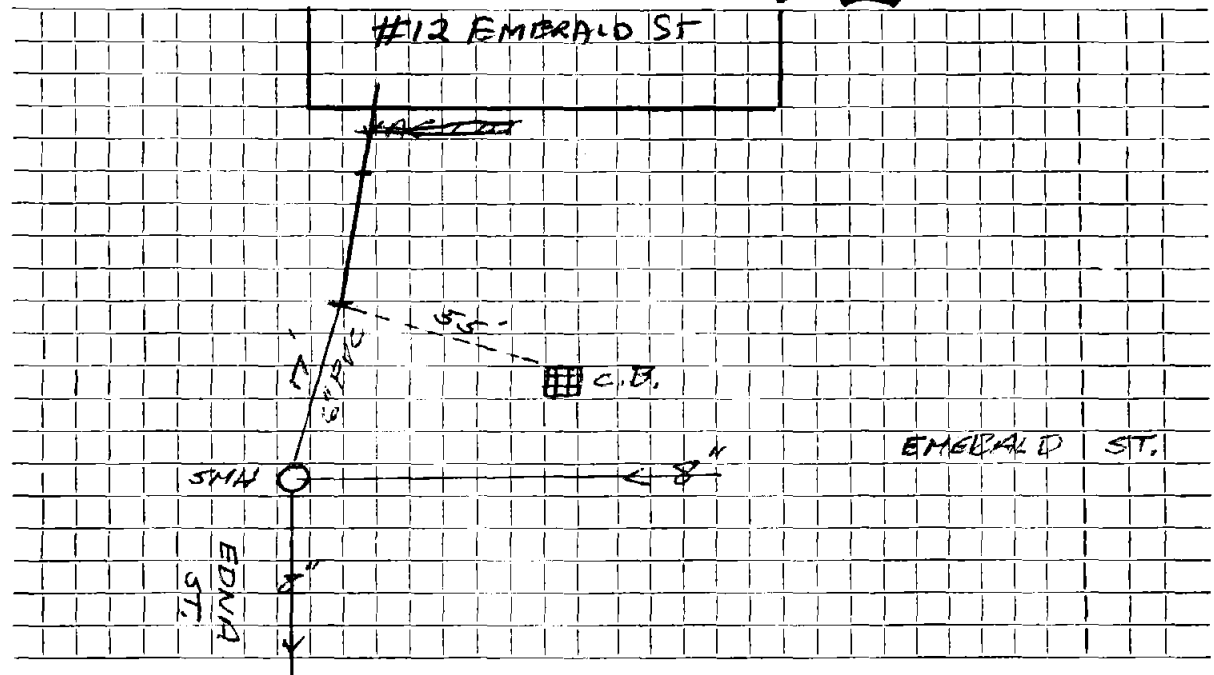

Connection made in EMERALD Street. Work completed APRIL 1986

Remarks: LEDGE