


DATE 7-21-77

TOWN OF LEXINGTON — BOARD OF PUBLIC WORKS
SEWER DIVISION

Sketch of Service Here 15

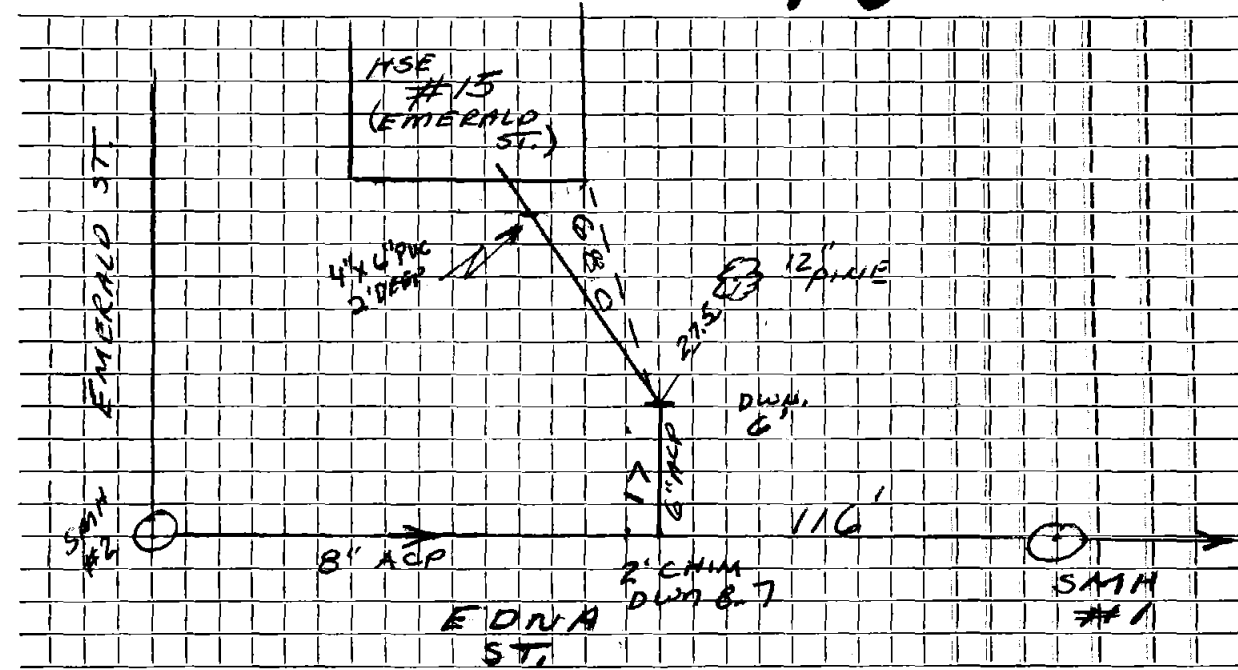

Connection made in EDNA ST. Street. Work completed 11-12-82

Remarks: