

Name Daniel Castanheira

Service No. 26

Address HSE #17 EMERALD ST.

Location

Kind of Pipe AC

Size 6"

Size of Main 8"

~~Repair Street~~ New Service Valeri #3498

Location AUG 4 1980


Date	Material	Amount	Total	Date	Amount
<del>2/24/77</del>	<del>21' 6" A.C.P.</del>	<del>\$10.00</del>	<del>\$210.00</del>	<del>6-24-80</del>	<del>Deposit</del>
12/24/80	83' 6" Transite pipe				\$10.00
				7-21-77	
				21' 6" A.C.P.	

DATE 7-21-27

TOWN OF LEXINGTON — BOARD OF PUBLIC WORKS  
SEWER DIVISION

Sketch of Service Here

17

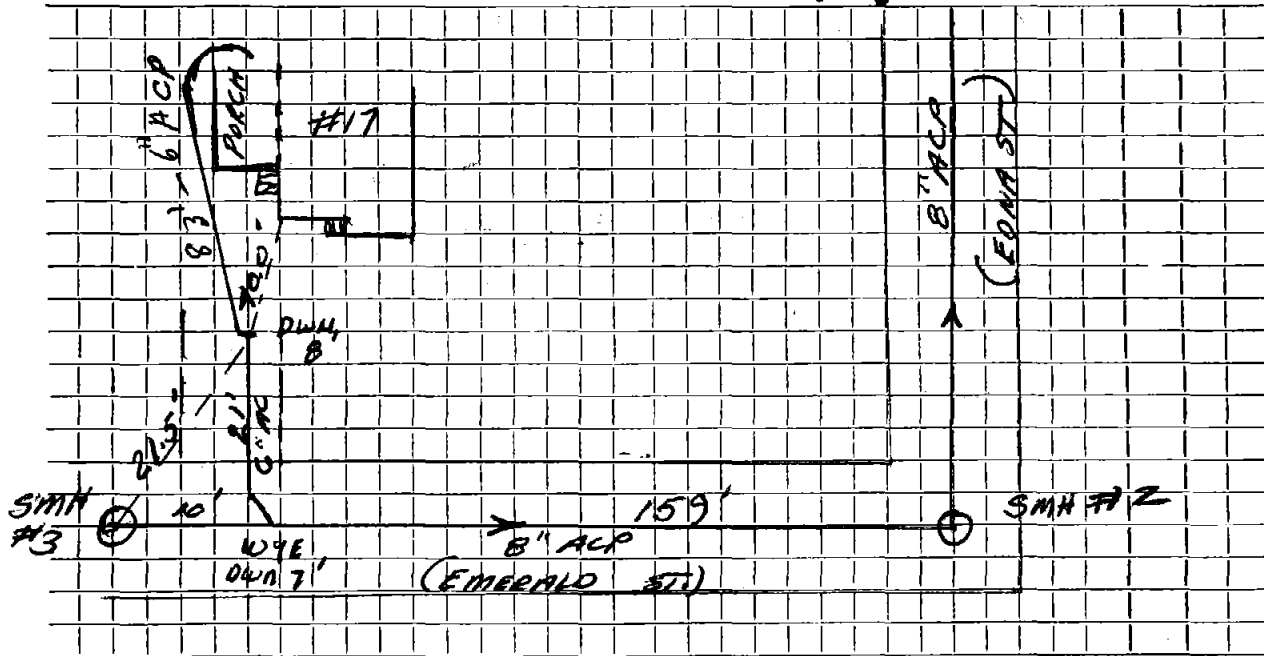

Connection made in EMERALD ST. Street. Work completed .....

Remarks: .....  
.....  
.....