


DATE _____

TOWN OF LEXINGTON — BOARD OF PUBLIC WORKS

SEWER DIVISION

Sketch of Service Here **849**

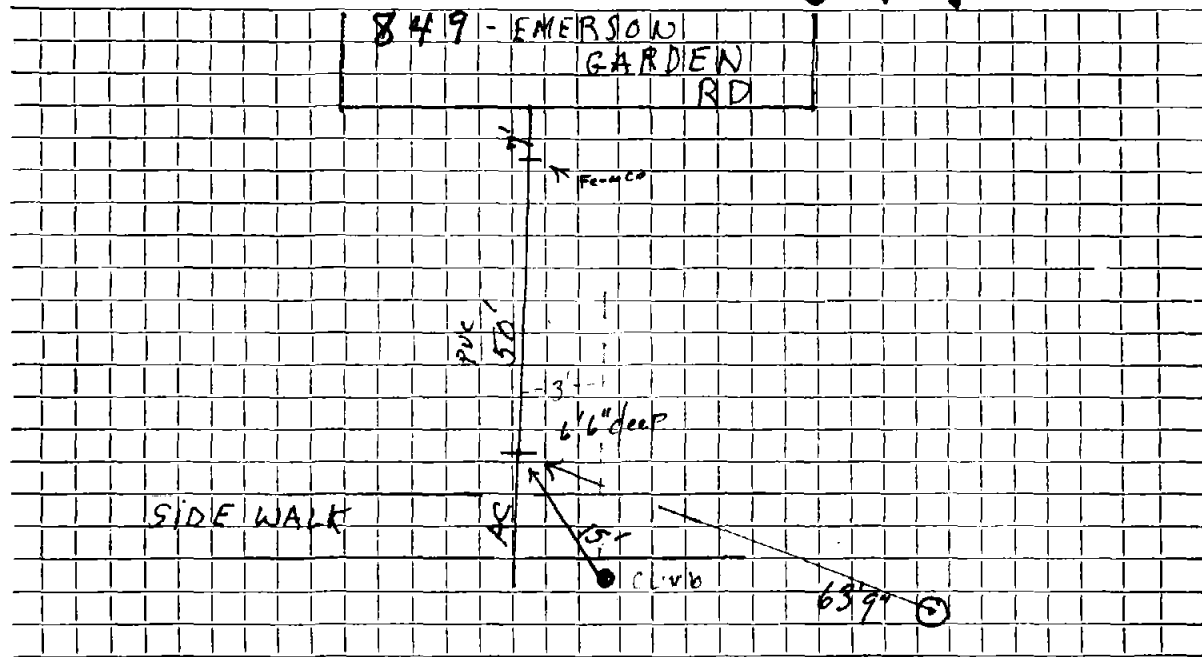

Connection made in Street. Work completed

Remarks: *Service was off RD.*

.....
.....