

Name DELUCA

Service No.

Address #851 EMERSON GARDENS ROAD

Location

Kind of Pipe

Size

Size of Main

Repair—Renewal—

New Service

PERMIT NO. 0977- SEAN TOCCI

Location

Date

Material

Amount

Total

Date

Amount

JUNE 25, 1997

41'-6"Ø PVC

6'-4"Ø PVC

1-6"X6" FERNCO


1-4"X6" FERNCO

1-45° ELBOW

DATE JUNE 25, 1997

TOWN OF LEXINGTON — BOARD OF PUBLIC WORKS
SEWER DIVISION

Sketch of Service Here

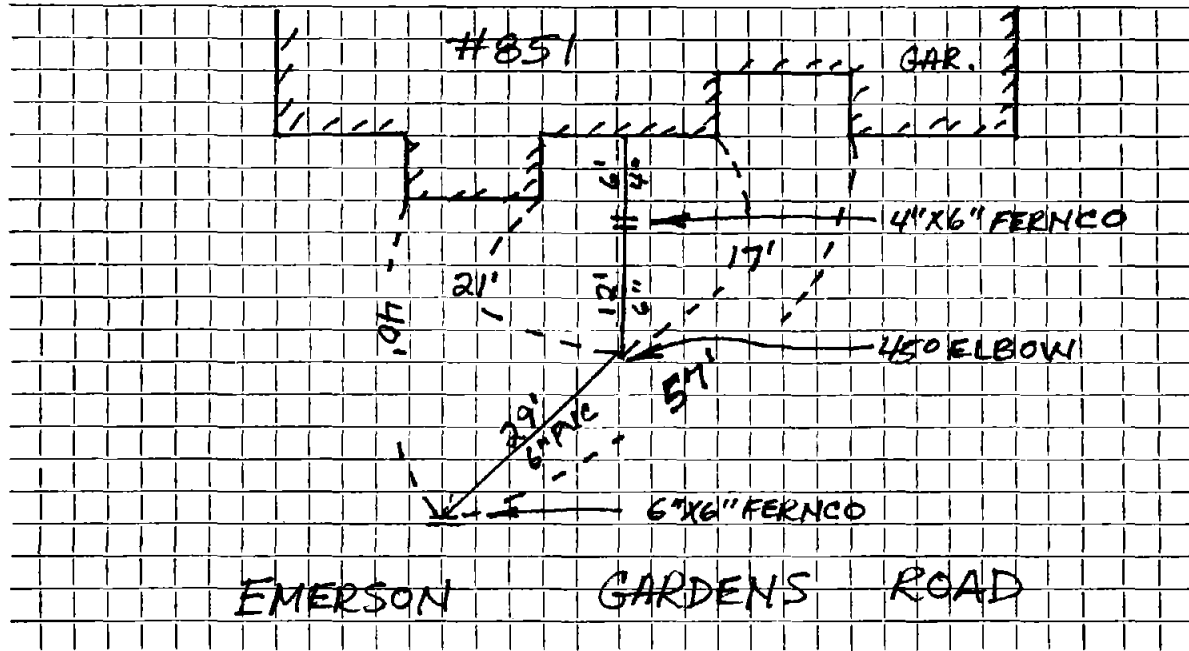

Connection made in EMERSON GARDENS ROAD Street. Work completed

Remarks: