


DATE _____

TOWN OF LEXINGTON — BOARD OF PUBLIC WORKS

SEWER DIVISION

Sketch of Service Here

853

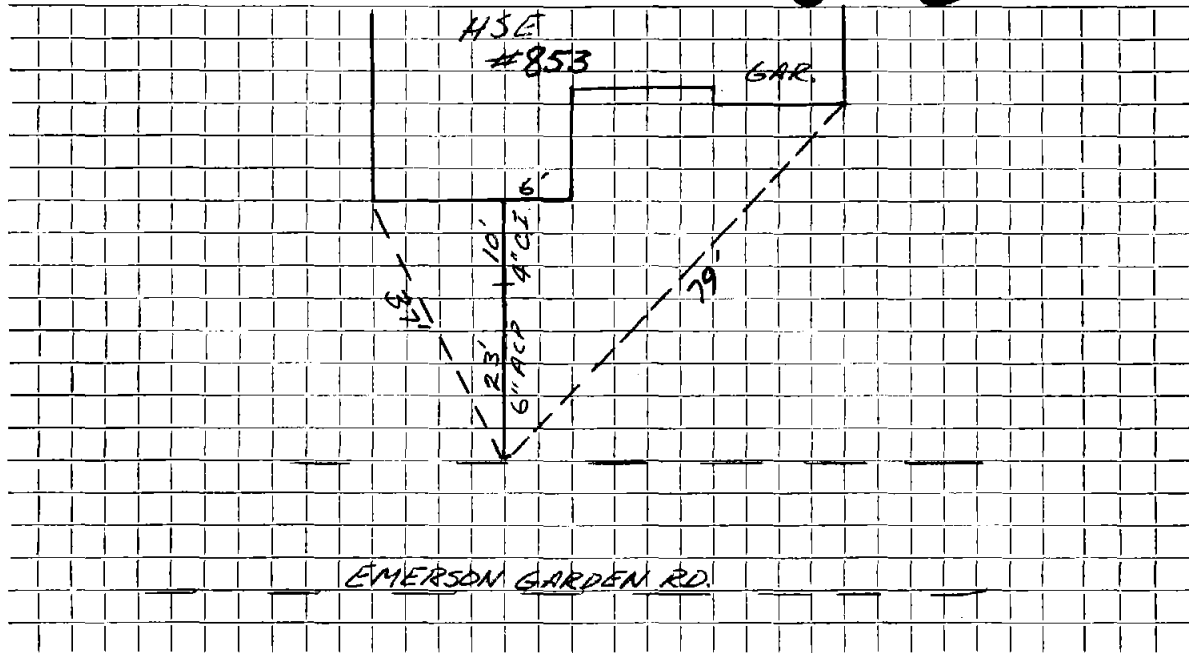

Connection made in EMERSON GARDEN RD. Street.

Work completed

Remarks:

.....
.....