
Name	EAST V	ILLAGE NO	DRSING	HOME	Service No.	
Address		REN GARDI				
				Location		
Kind of Pipe			Size		Size of Main	
Repair—Rei	newal—New Service				Location	
Date	Material	Amount	Total	Date		Amou
						_
			Ł			
-						

DA.	TE_			

## TOWN OF LEXINGTON - BOARD OF PUBLIC WORKS

## SEWER DIVISION

## Sketch of Service Here

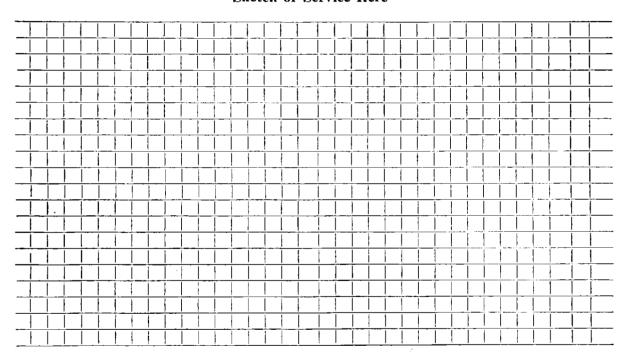

Connection made in Street.	Work completed
Remarks:	
	,
•	