

Name Emerson Garden Realty Cooperation

Service No.

Address ~~843~~ Emerson Rd. ^{Garden Rd} Lexington, Mass.

Location

Kind of Pipe

Size

Size of Main

Repair—Renewal—New Service

Dave Eagle #2597


Location

Date	Material	Amount	Total	Date	Amount
11/13/74 53'	6" Transite Pipe				
10'	4" Cast Iron Pipe				

DATE _____

TOWN OF LEXINGTON — BOARD OF PUBLIC WORKS
SEWER DIVISION

Sketch of Service Here **843**

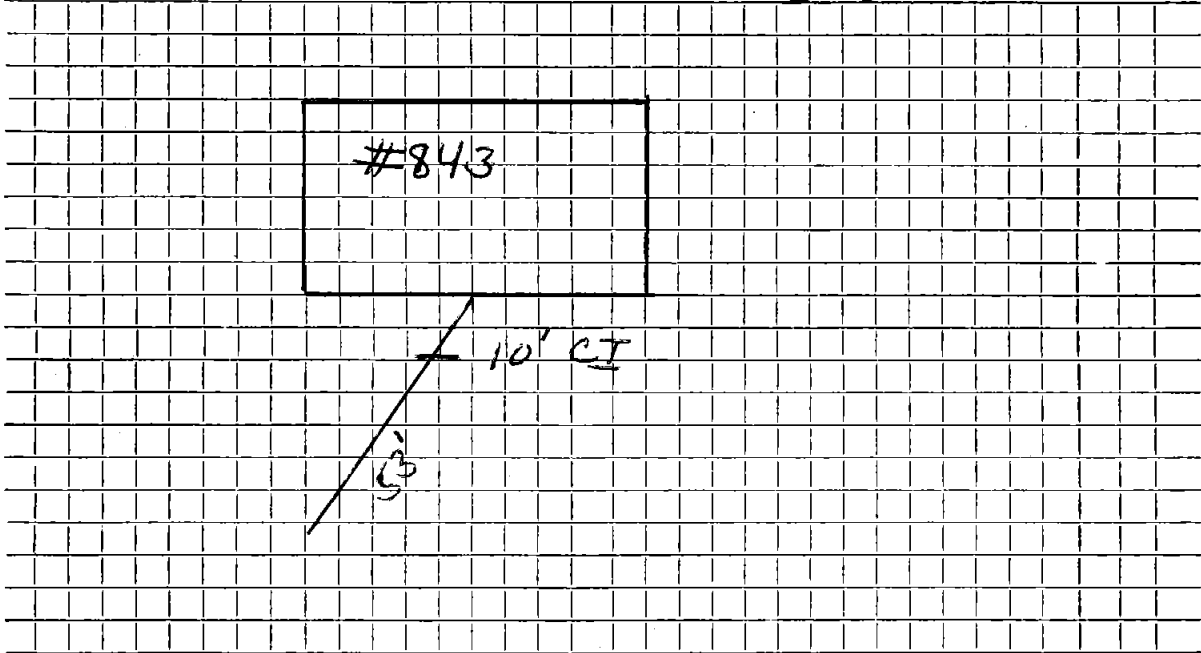

Connection made in Street. Work completed

Remarks:
.....
.....